

OREGON CORNER RESTORATION FORM

Section 10 Township 2N Range 33E

County UMATILLA Date MAY 1989

CORNER DESIGNATION

1/4 SEC 10/11, G-17

- Condition Report Only
- Not Found
- Renewed
- Unrecorded
- Surveyed In
- Referenced Out


Previous Renewals/Surveys, etc. _____

1982 SURVEY BY WELLS FOR UMATILLA RESERVATION HOUSING AUTHORITY

Monument(s) & Accessories Found: (Condition and Source)

FOUND 2" ALUM. CAP IN MONUMENT BOX MARKED LS. 1099 FOR SHORT MILE ROAD CONSTRUCTION

Monument Detail

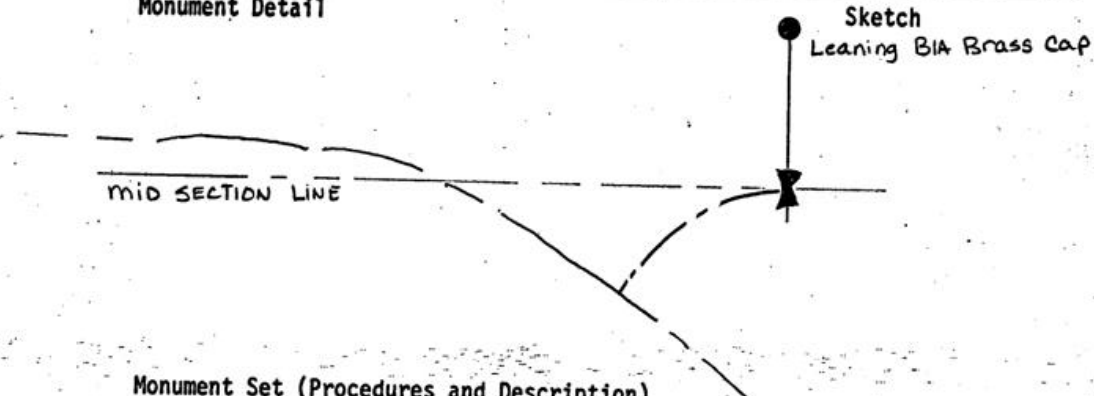

Monument Set (Procedures and Description)

NONE

New Accessories

NONE

Location & Comments

NEW RECORD OF SURVEY Compass Declination _____
FOR UIR 8(1) Firm/Agency _____
MISSION HIGHWAY WHITE SHIELD, INC.
RECEIVED BY Address P.O. BOX 477
Umatilla County Surveyor GRANDVIEW, WA 98930
Date 7-89 Party Chief MIKE LEJEUNE
Rec'd by KL Notes _____
89 98-B Witness THOMAS BAKER

Surveyor's Seal

