

PUBLIC LAND CORNER CONDITION REPORT

UMATILLA COUNTY, DATE: 01/08/02

CORNER DESIGNATION: 2N33G21, The East Quarter Corner of Section 11.

PREVIOUS RENEWALS/ SURVEYS, ETC.:

Most recent Umatilla County Surveyors recorded survey: 99-164-B.

MONUMENT AND ACCESSORIES FOUND:

Found a 5/8" iron rebar with yellow plastic cap stamped "OR PLS 1106, WA PLS 17273", buried 8" below ground in a pasture. There is no corner certificate.

MONUMENT MARKING DETAIL:

LOCATION & COMMENTS:

Corner is located in a pasture, at East end of Short Mile Road and South of railroad tracks.


STATE PLANE COORDINATE, OREGON NORTH ZONE, NAD83/91, INT. FOOT:

N = 734933.88


E = 8676916.94

FIRM/AGENCY: William R. Wells, PLS
P.O. Box 1696
Pendleton, Oregon 97801

\2N33G21

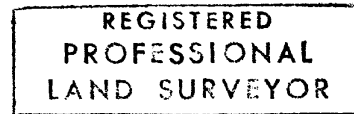

William R. Wells

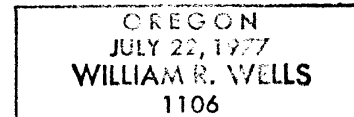

renews 6-30-02

RECEIVED BY

Umatilla County Surveyor

Date 2-02

Rec'd by KK

No. 02-43-9