

PUBLIC LAND CORNER CONDITION REPORT

UMATILLA COUNTY, DATE: 12/21/01

CORNER DESIGNATION: 2N33J21, The Northeast Corner of Section 14.

PREVIOUS RENEWALS/ SURVEYS, ETC..:

Most recent Umatilla County Surveyors recorded survey: 99-96-C.

MONUMENT AND ACCESSORIES FOUND:

Found P.K. nail 1 inch below asphalt, PK nail is believed to be set over buried brass cap. Located in Cayuse Road approximately 3.0 feet South of painted centerline stripe. Corner has no visible accessories.

MONUMENT MARKING DETAIL:

LOCATION & COMMENTS:

Corner located just West of bridge crossing Mission Creek in Cayuse Road.


STATE PLANE COORDINATE, OREGON NORTH ZONE, NAD83/91, INT. FOOT:

N = 732274.42


E = 8676956.60

FIRM/AGENCY: William R. Wells, PLS
P.O. Box 1696
Pendleton, Oregon 97801

\2N33J21

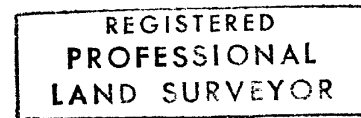

William R. Wells

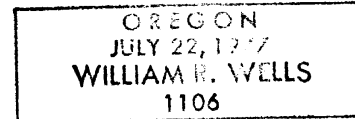

renews 6-30-02

RECEIVED BY

Umatilla County Surveyor

Date 2-02

Rec'd by KK

No. 02-43-9

△