

PUBLIC LAND CORNER CONDITION REPORT

UMATILLA COUNTY, DATE:

CORNER DESIGNATION: 2N33N11, The North 1/4 Corner of Section 21.

PREVIOUS RENEWALS/ SURVEYS, ETC.:

Most recent Umatilla County Surveyors recorded corner record: 97-222-C.

MONUMENT AND ACCESSORIES FOUND:

Found a 2 1/2" brass cap with top 4" above ground level.
Monument marked as shown in monument marking detail.
As per corner record, accessories are intact.

MONUMENT MARKING DETAIL:

T2N R33E
1 S16
4 S21
1997
PLS 1106


LOCATION & COMMENTS: Corner is located by guard rail barricade, just North of freeway fence of Interstate 84.

STATE PLANE COORDINATE, OREGON NORTH ZONE, NAD83/91, INT. FOOT:


N = 726702.32
E = 8663817.20

FIRM/AGENCY: William R. Wells
P.O. Box 1696
Pendleton, Oregon 97801

2N33N11

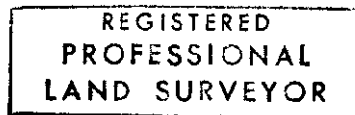

William R. Wells

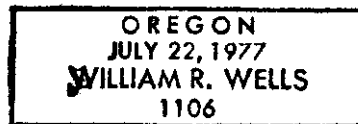

renews 6/30/02

RECEIVED BY
Umatilla County Surveyors
Date 5-02
Rec'd By KK
No. 02-117-9