

PUBLIC LAND CORNER CONDITION REPORT

UMATILLA COUNTY, DATE: 02/20/02

CORNER DESIGNATION: 2N33R9, The Northeast Corner of Section 29.

PREVIOUS RENEWALS/ SURVEYS, ETC.:

Most recent Umatilla County Surveyors recorded corner record: 94-110-A.

MONUMENT AND ACCESSORIES FOUND:

Found a 2 1/2" brass cap 6" below paved road.

Monument marked as shown in monument marking detail.

As per corner record accessories are intact, except 3/4" x 36" iron rod bearing S 35°35' W, 31.55 feet is bent over and bearing object sign is gone.

MONUMENT MARKING DETAIL:

T2N R33E

S20 | S21

S29 | S28

1994

RLS 1333

LOCATION & COMMENTS:

Located at intersection of Tutuilla Road and Billy Road.


STATE PLANE COORDINATE, OREGON NORTH ZONE, NAD83/91, INT. FOOT:

N = 721309.20


E = 8661245.74

FIRM/AGENCY: William R. Wells
P.O. Box 1696
Pendleton, Oregon 97801

2N33R9

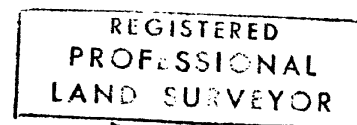

William R. Wells

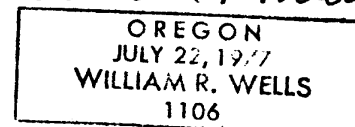

renews 6/30/02

RECEIVED BY

Umatilla County Surveyor

Date 5-02

Rec'd By KK

No. 02-119-9