

PUBLIC LAND CORNER CONDITION REPORT

UMATILLA COUNTY, DATE: 10/03/01

CORNER DESIGNATION: 2N33, X-5, The East 1/4 Corner of Section 31.

PREVIOUS RENEWALS/ SURVEYS, ETC..:

Most current is Umatilla County Surveyor's Corner Record No. 95-46-A.

MONUMENT AND ACCESSORIES FOUND:

Found a 2 1/2" brass cap monument, 2" below ground surface in good condition, marked as shown in monument marking detail. All accessories are intact per record Corner Record. The corner has four accessories.

MONUMENT MARKING DETAIL:

T2N R33E
1/4
S31|S32
1995
RLS 1333

LOCATION & COMMENTS:


Corner located 1.5 feet West of a railroad tie fence post with fences running East and South.

STATE PLANE COORDINATE, OREGON NORTH ZONE, NAD83/91, INT. FOOT:


N = 713195.18
E = 8656174.10

FIRM/AGENCY: William R. Wells, PLS
P.O. Box 1696
Pendleton, Oregon 97801

2N33X5

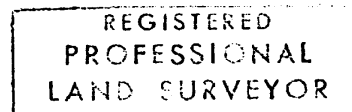

William R. Wells

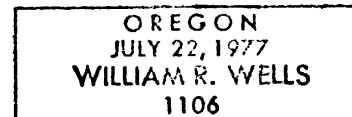

renews 6-30-02

RECEIVED BY
Umatilla County Surveyor
Date 12-01
Rec'd By KE
No. 01-211-9