

OREGON CORNER RESTORATION FORM

Section 32 Township 2N Range 33E

County Umatilla Date 3-17-95

X-5
X-5

CORNER DESIGNATION

- Condition Report Only
- Not Found
- Renewed
- Unrecorded
- Surveyed In
- Referenced Out



Previous Renewals/Surveys, etc. In 1887 Currin & Noland deposited a charred stake and dug two pits and raised a mound and there is no remaining evidence.

Monument(s) & Accessories Found: (Condition and Source)

No evidence found.

Monument Detail

Sketch

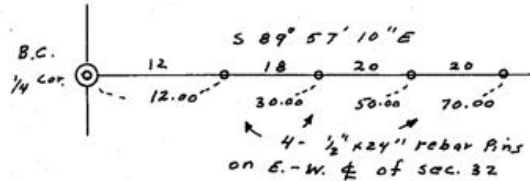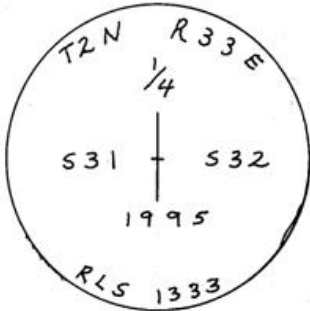

Monument Set (Procedures and Description)

Set 2 1/2" brass cap on 1" x 30" G.I.P. w/flare at ground surface half way between the north and south section corners.

New Accessories

1/2" x 24" rebar bears S89°57'10"E 12.00 feet

1/2" x 24" rebar bears S 89°57'10"E 30.00 feet

1/2" x 24" rebar bears S89°57'10"E 50.00 feet

1/2" x 24" rebar bears S89°57'10"E 70.00 feet

Location & Comments

In traveled area between fields

Compass Declination _____

Firm/Agency Don Staebler

Eng.-Surveyor _____

Address 1532 SW 41 St.

Pendleton, OR 97801

Party Chief Don Staebler

Notes _____

Witness _____

Surveyor's Seal



Donald L. Staebler



Expires 6-30-96

RECEIVED BY

Umatilla County Surveyor

Date 4-95

Rec'd by KR

No. 95-46-A

Donald L. Staebler