

Index

File No. Z-15

CORNER RECORD (SEARCH)

(Ref. FSM 7151.4)

Tract or

Survey No. _____

Cor.

No. _____

T 2N R. 36E

R.D. Walla Walla


County Umatilla

Merid. Willamette

N.F. Umatilla

State Oregon

CORNER DIAGRAM

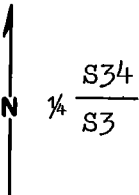

DESCRIBE CORNER MONUMENT FOUND

Stone 16"x16"x8" 1/4 on North face.

DESCRIBE BEARING TREES OR OTHER OFFICIAL ACCESSORIES FOUND

Orig. 14" now 6" Pine stub 4 ft. tall with 1/4S upper blaze and BT lower blaze S85W-10.8 ft. (record 9.9). Northwest BT gone.

PHOTO IDENTIFICATION DATA

Photo No. 480-229

Filed At. Umatilla N.F.

Object Ident. two I.P.'s

Ident. By L. D. ...
Signature

DESCRIBE CORNER LOCATION RELATIVE TO NEAR-BY FEATURES, ALSO HOW TO REACH CORNER

Corner is on West side of small fork of Camp Creek about 1/2 mile North of cabin at junction.

PLANE COORDINATE POSITION DATA

State _____ Zone _____

X _____

Y _____

Estob. By _____
Agency

Signature
Larry D. ...

Title
Land Surveyor

Division _____

Headquarters _____

Date

6/83

7100-52-(3/68)

CORNER RECORD (PERPETUATION)

MONUMENT: DESCRIBE NEW MONUMENT SET, OR WORK DONE TO PRESERVE EXISTING MONUMENT

Set 2½"x30" Aluminum pipe with a 2½" Aluminum cap 16" in ground-built mound of stone 3 ft. base 14" high.

ACCESSORIES : DESCRIBE NEW BT'S WITNESS OBJECTS ETC. ESTABLISHED, OR WORK DONE TO PRESERVE EXISTING EVIDENCE

14" D-Fir North 26.4 ft. scribed ¼S34BT and with a 1" Brass disk stamped PLS 896.
22" Pine S1W-39.0 ft. scribed ¼S3BT and with a 1" Brass disk stamped PLS 896.

Work Done By Larry D. Bishop Title Surveyor Date 6/83 State Registration No. 896
or Agency

Certified Cor. Record Prepared ? Yes No Filed At: _____ Date _____

REMARKS

Set guard post East with sign 54-4 only.
Nailed 54-4 and BT signs to BT's and painted band and blazes red.

Index

File No. Z-15

CORNER RECORD (SEARCH)

(Ref. FSM 7151.4)

Tract or

Survey No. _____

Cor.

No. _____


T 2N R. 36E

R.D. WALLA WALLA County UMATILLA

Merid. WILL

N.F. UMATILLA State OREGON

CORNER DIAGRAM

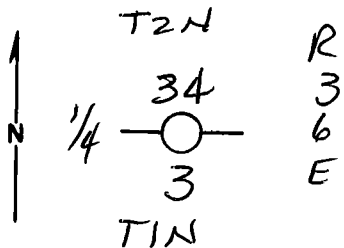

DESCRIBE CORNER MONUMENT FOUND

NONE FOUND

DESCRIBE BEARING TREES OR OTHER OFFICIAL ACCESSORIES FOUND

NONE FOUND

PHOTO IDENTIFICATION DATA

Photo No. _____

Filed At. _____

Object Ident. _____

Ident. By _____

Signature

PLANE COORDINATE POSITION DATA

State _____ Zone _____

X _____

Y _____

Estab. By _____

Agency

DESCRIBE CORNER LOCATION RELATIVE TO NEAR-BY FEATURES, ALSO HOW TO REACH CORNER

Signature

Title

Division

Headquarters

Date

7100-52 (3. 68)

Dennis L. Gaylord

PLS

1636

7-22-82

CORNER RECORD (PERPETUATION)

MONUMENT: DESCRIBE NEW MONUMENT SET, OR WORK DONE TO PRESERVE EXISTING MONUMENT

ACCESSORIES : DESCRIBE NEW BT'S WITNESS OBJECTS ETC. ESTABLISHED, OR WORK DONE TO PRESERVE EXISTING EVIDENCE

Work Done By _____ **Title** _____ **Date** _____ **State Registration No.** _____
or Agency _____

Certified Cor. Record Prepared ? Yes No **Filed At:** _____ **Date** _____

REMARKS

Index File No.

T.

R.

M.

Tract or Surv. No.

Cor.

12

13