

Index

File No. Z-23

**CORNER RECORD (SEARCH)**

(Ref. FSM 7151.4)

Tract or

Survey No. \_\_\_\_\_

Cor.

No. \_\_\_\_\_

T 2N R. 36E

R.D. Walla Walla


County Umatilla

Merid. Willamette

N.F. Umatilla

State Oregon

CORNER DIAGRAM Sec. 36

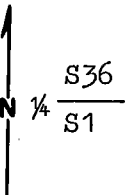

**DESCRIBE CORNER MONUMENT FOUND**

Basalt stone 12x10x6 (record 14x10x8) lying loose on ground-  
no marks identifiable.

**DESCRIBE BEARING TREES OR OTHER OFFICIAL ACCESSORIES FOUND**

Orig. 36" now down and rotted Pine stump with axe marks N36E-  
84 ft. (record 188 lks.-possibly should have been 128 lks.).  
48" Pine East 80 ft. with line blazes East and West-West blaze  
previously opened to verify date-fits creek call West very well.

**PHOTO IDENTIFICATION DATA**

Photo No. 1280-50

Filed At. Umatilla N.F.

Object Ident. two I.P.'s

Ident. By L. B. Bising  
Signature

**PLANE COORDINATE POSITION DATA**

State \_\_\_\_\_ Zone \_\_\_\_\_

X \_\_\_\_\_

Y \_\_\_\_\_

Estob. By \_\_\_\_\_  
Agency

**DESCRIBE CORNER LOCATION RELATIVE TO NEAR-BY FEATURES, ALSO HOW TO REACH CORNER**

From the signed wood post where the East line of Section 36  
crosses Rd.#3128 go West on Rd.#3128 approx 0.4 mile to Jeep  
road South. Follow Jeep road to point of ridge and posted line-  
corner is West 400 ft. to 600 ft..

Signature  
Larry D. Bising

Title  
Land Surveyor

Division

Headquarters

Date 6/83 7100-52-(3.68)

**CORNER RECORD (PERPETUATION)**

**MONUMENT: DESCRIBE NEW MONUMENT SET, OR WORK DONE TO PRESERVE EXISTING MONUMENT**

Set 2½" x 30" Aluminum pipe with a 2½" Aluminum cap 10" in ground-built mound of stone 4 ft. base 20" high.

**ACCESSORIES: DESCRIBE NEW BT'S WITNESS OBJECTS ETC. ESTABLISHED, OR WORK DONE TO PRESERVE EXISTING EVIDENCE**

13" P. Pine N47¼E-88.8 ft. scribed ¼S36BT and with a 1" Brass disk stamped PLS 896.

4" Pine S42¼E-143.2 ft. nailed BT sign only-no blaze.

Work Done By Larry D. Bishop Title Surveyor Date 6/83 State Registration No. 896  
or Agency

Certified Cor. Record Prepared? Yes No  Filed At: \_\_\_\_\_ Date \_\_\_\_\_

**REMARKS**

Nailed 54-4 and BT signs to BT's and painted band and blazes red.  
Set guard post East with signs 54-2 and 54-4.

Index File No. Z-23

T 2N R. 36E

Merid. Will

CORNER RECORD (SEARCH)

(Ref. FSM 7151.4)

Tract or

Survey No. \_\_\_\_\_


Cor.

No. \_\_\_\_\_

R.D. WALLA WALLA County UMATILLA

N.F. UMATILLA State OREGON

CORNER DIAGRAM

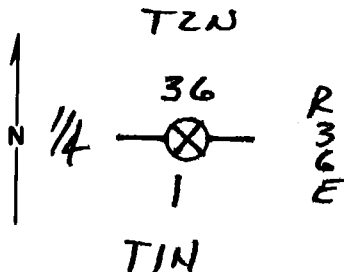

DESCRIBE CORNER MONUMENT FOUND

STONE LYING LOOSE ON GROUND - IS A BIT SMALLER THAN RECORD SIZE - NO MARKS VISIBLE.

DESCRIBE BEARING TREES OR OTHER OFFICIAL ACCESSORIES FOUND

ORIG. 36" PINE B.T. IS DOWN & BADLY DECAYED. NO MARKS OR SCRIBES REMAIN. BEARS N360E, 91'-FT. A 48" PINE BEARS EAST 80'± & HAS ORIGINAL LINE BLAZES ON EAST & WEST SIDES. BLAZE ON WEST SIDE HAS BEEN

PREVIOUSLY CHOPPED OPEN. CREEK CALL TO WEST FITS PERFECTLY. (389 FT WEST)

PHOTO IDENTIFICATION DATA

Photo No. \_\_\_\_\_

Filed At. \_\_\_\_\_

Object Ident. \_\_\_\_\_

Ident. By \_\_\_\_\_

Signature

PLANE COORDINATE POSITION DATA

State \_\_\_\_\_ Zone \_\_\_\_\_

X \_\_\_\_\_

Y \_\_\_\_\_

Estab. By \_\_\_\_\_

Agency

Signature

Title

Division

Headquarters

Date

7100-52 (3. 68)

*Dennis J. Hayford*

PLS 1636

7-8-82

**CORNER RECORD (PERPETUATION)**

**MONUMENT : DESCRIBE NEW MONUMENT SET, OR WORK DONE TO PRESERVE EXISTING MONUMENT**

**ACCESSORIES : DESCRIBE NEW BT'S WITNESS OBJECTS ETC. ESTABLISHED, OR WORK DONE TO PRESERVE EXISTING EVIDENCE**

**Work Done By** \_\_\_\_\_ **Title** \_\_\_\_\_ **Date** \_\_\_\_\_ **State Registration No.** \_\_\_\_\_  
**or Agency** \_\_\_\_\_ 10

**Certified Cor. Record Prepared ?** Yes  No  **Filed At:** \_\_\_\_\_ **Date** \_\_\_\_\_ 11

**REMARKS**

**Index File No.**      **T.**      **R.**      **M.**      **Tract or Surv. No.**      **Cor.**      12