

Form 874-9—Revised May, 1918

U. S. DEPARTMENT OF AGRICULTURE  
FOREST SERVICE

NATIONAL FOREST

CORNERS OF THE PUBLIC SURVEY

T. 21 R. 10 Mer.

Corner common to Sections

and

Corner consists of a stone (not) in place



State condition

Dimensions above ground \_\_\_\_\_ inches.

Sketch grooves, letters, figures, or notches, on proper face or edge.

CARDINAL POSITION

DIAGONAL POSITION

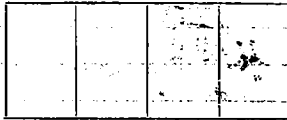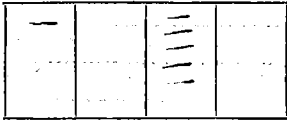

Mound of \_\_\_\_\_ is located \_\_\_\_\_

Pits are located \_\_\_\_\_

Sketch markings of Bearing Trees (or Rocks) in proper box and fill blanks below, giving bearings from Corner to Trees and Distances in Links.

T21  
R37E  
51

[Blank box]

T21  
R37E  
512

[Blank box]

BT

[Blank box]

BT

[Blank box]

Species Y.P.

Diameter 27 in

Bearing 218W

Distance 14 1/2

Do you believe this to be a genuine Land Office Corner? Yes

If not, why? \_\_\_\_\_

Signature

Date


Title

8-3027

T. 2 N. R. 37. E W Mer.

9-3027

(Make sketch of topography near Corner.)

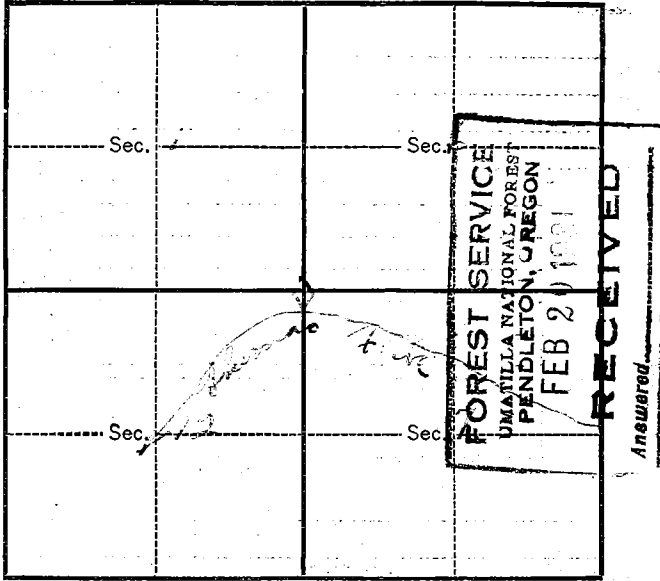

Metal Location Poster is on a 2 1/2  
 tree 3 1/2 inches diameter, on the SE  
 side of 3000  
 from which this Corner bears N 52 E  
1 chains distant.

Give any further facts which will aid in finding this  
 Corner again.

*From west end of the line  
 west 1/2 mile about 1/4 mile  
 down from the end  
 to the first of way up hill  
 north of road. Spruce  
 with the light. Poster  
 in plain sight.*