

Index  
File No. G-17

CORNER RECORD (SEARCH)

(Ref. FSM 7151.4)

Tract or Survey No. \_\_\_\_\_ Cor. No. \_\_\_\_\_


T 2N R. 37E

R.D. WALLA WALLA County UMATILLA

Merid. WILL

N.F. UMATILLA State OREGON

CORNER DIAGRAM

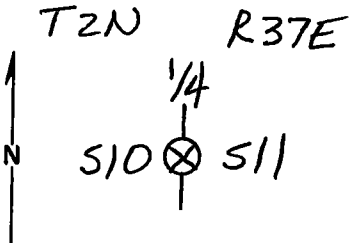

DESCRIBE CORNER MONUMENT FOUND

STONE, 19" x 8" x 5" IS LOOSE ON GROUND & ABOUT 20' off, DOWNHILL FROM CORNER POINT & MARKED "1/4"

DESCRIBE BEARING TREES OR OTHER OFFICIAL ACCESSORIES FOUND

ORIG. 3 6" PINE IS A BROKEN & DECAYED SNAG - NO MARKS REMAIN. BEARS N41°E, 110 LKS (72.6 ft.)

ORIG. 30" PINE IS DOWN. SCRIBES "1/4 S10" VISIBLE ON OPEN BLAZE. ROOT HOLE BEARS S44°W, 120 LKS (79.2 ft.)

DESCRIBE CORNER LOCATION RELATIVE TO NEAR-BY FEATURES, ALSO HOW TO REACH CORNER

PUT BT SIGNS ON BOTH ORIG. B.T'S & A LOCATION POSTER ON AN 8" PUNDEROSA PINE N66°W, 70 FT. FROM CORNER. PLACED A LOCATION POSTER ON A 20" POND. PINE 4 1/2 CHAINS NORTH (300 FT.) OF CORNER ON RIDGE TOP,

PHOTO IDENTIFICATION DATA

Photo No. \_\_\_\_\_  
Filed At. \_\_\_\_\_  
Object Ident. \_\_\_\_\_  
Ident. By \_\_\_\_\_  
*Signature*

PLANE COORDINATE POSITION DATA

State \_\_\_\_\_ Zone \_\_\_\_\_  
X \_\_\_\_\_  
Y \_\_\_\_\_  
Etab. By \_\_\_\_\_  
*Agency*

*Signature*

*Title*

*Division*

*Headquarters*

*Date*

FS-7100-52 (3/68)

*Dennis L. Gaylord*

PLS 1636

10-30-89

**CORNER RECORD (PERPETUATION)**

**MONUMENT: DESCRIBE NEW MONUMENT SET, OR WORK DONE TO PRESERVE EXISTING MONUMENT**

9

**ACCESSORIES : DESCRIBE NEW BT'S WITNESS OBJECTS ETC. ESTABLISHED, OR WORK DONE TO PRESERVE EXISTING EVIDENCE**

10

Work Done By \_\_\_\_\_ Title \_\_\_\_\_ Date \_\_\_\_\_ State Registration No.  
or Agency \_\_\_\_\_

Certified Cor. Record Prepared ? Yes No Filed At: \_\_\_\_\_ Date \_\_\_\_\_

11

**REMARKS**

12

Index File No. T. R. M. Tract or Surv. No. Cor. \_\_\_\_\_

13