

Form 874-9—Revised May, 1918

U. S. DEPARTMENT OF AGRICULTURE
FOREST SERVICE

Umatilla NATIONAL FOREST

CORNERS OF THE PUBLIC SURVEY

T. 2 North R. 37 East Will. Mer.

14 Section Corner common to Sections
23, 26, and —

Corner consists of a Pile of Rocks () in place
State condition In good condition

Dimensions above ground 8/10/14 inches.
Sketch grooves, letters, figures, or notches, on proper face or edge.

CARDINAL POSITION

DIAGONAL POSITION

Mound of _____ is located _____

Arise _____ Pits are located _____

Sketch markings of Bearing Trees (or Rocks) in proper box and fill blanks below, giving bearings from Corner to Trees and Distances in Links.

<u>1/4 S</u> <u>26</u>		<u>1/4 S</u> <u>23</u>	
<u>BT</u>		<u>BT</u>	

Species D.K. Y.P.

Diameter 25 in. 27 in.

Bearing S. 66 W. N 42 W.

Distance 1.40 ch. 1.64 ch.

Do you believe this to be a genuine Land Office Corner? Yes.
If not, why? _____

Gerald J. Tucker
Signature


Forest Ranger
Title

Date.

T. 2 North R. 37 East W. — Mer.

8-3027

(Make sketch of topography near Corner.)

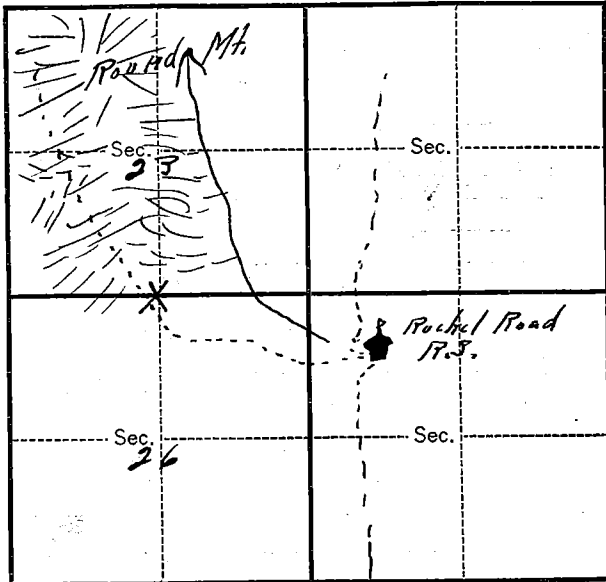

Metal Location Poster is on a Y.P.
tree 30 inches diameter, on the North West
side of the corner
from which this Corner bears South 60° East
1.25 chains distant.

Give any further facts which will aid in finding this
Corner again.


This corner is in the Round Mt. Trail
about 100 yards from where the trail
crosses on top of the Round Mt. Ridge.
The corner is about two feet from
the trail and is well marked
by a mound of rocks. South
upward, on Ridge top, about
5% slope.

LAND CORNER RECORD

LL 5680-2

1. T 2N R 37E No. R-19 Cor. 1/4 Meritall State Ore. (Rectangular) N. F. Uma. Dist. Pend 5

2. Corner Status

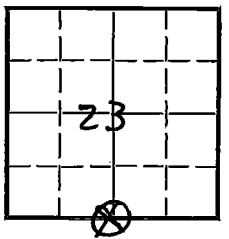

3. Original Description _____ Vol. 454 Page 325 Where Recorded BLM.

4. Description of Corners: Basalt stone 15x7x7 10" in ground
Fir 18" dia 520 w 40 lks
Pine 30" " N47 w 23 lks

7. Photo Identification

Photo No. _____

Ident. By: _____

8. Plane Coordinate Position Data

State _____ Zone _____

X _____

Y _____

Estab. By _____

Field Book No. _____

Where Filed _____

9. Evaluation

Authentic _____

Needs Verif. X Monument No

Re-estab. _____ Survey _____

Land Status _____

5. Investigation Notes: Pile of Rocks
Fir 20" Dia 566°w 1.40 ch.
Pine 27" " N42 W 1.64 ch. } Do not agree
 } with original
 } notes. J&K 3/75
scribing visible in both trees.
Metal Paster on a 30" Pine N60 west
of corner 1.25 ch

6. Signed Tucker Title P.R. Date 1927

Handwritten initials

PERPETUATION RECORD

10. Monument:

11. Accessories

Field Book _____ Page _____

12. Set By _____ Title _____

13. Recorded By _____ Volume _____ Page _____

(Agency)

License _____ Agency _____ Date _____

(Date) _____ (City) _____ (County) _____ (State) _____

14. Remarks:

R-19