

Form 874-9

U. S. DEPARTMENT OF AGRICULTURE
FOREST SERVICE

Umatilla NATIONAL FOREST

CORNERS OF THE PUBLIC SURVEY
T. 2 N R. 37 E Willamette Mer.

Section _____ Corner common to Sections
23, 24, 25, and 26

DESCRIPTION OF CORNER

Corner consists of a Fir Post, rocks

Dimension above ground 4x4x20 inches.
Sketch grooves, letters, figures, or notches, on proper face or edge.

CARDINAL POSITION				DIAGONAL POSITION			
		=	-	S 23	S 26	S R37 E	T2N S24
N	W	S	E	NW	SW	SE	NE

Mound of _____ is located _____

Pits are located _____
Sketch markings of Bearing Trees (or Rocks) in proper box and fill blanks below, giving bearings from Corner to Trees and Distances In Links.

T2N R37E S23	T2N R37E S 26	S	2N 37E 24
B T			

Species	<u>DF</u>	<u>DF</u>	<u>DF</u>	<u>DF</u>
Diameter	<u>24"</u>	<u>20"</u>	<u>21 1/2"</u>	<u>33"</u>
Bearing	<u>N25W</u>	<u>S36W</u>	<u>S27E</u>	<u>N36E</u>
Distance	<u>23'</u>	<u>22'</u>	<u>21'4"</u>	<u>31'8"</u>

Do you believe this to be a genuine Land Office Corner? Yes
If not, why? _____


Arnold J. Tucker
Signature

Aug. 10, 1928
Date, Forest Ranger
Title.

T. 2 N R. 37 E W Mer.

8-3027

(Make sketch of topography near Corner.)

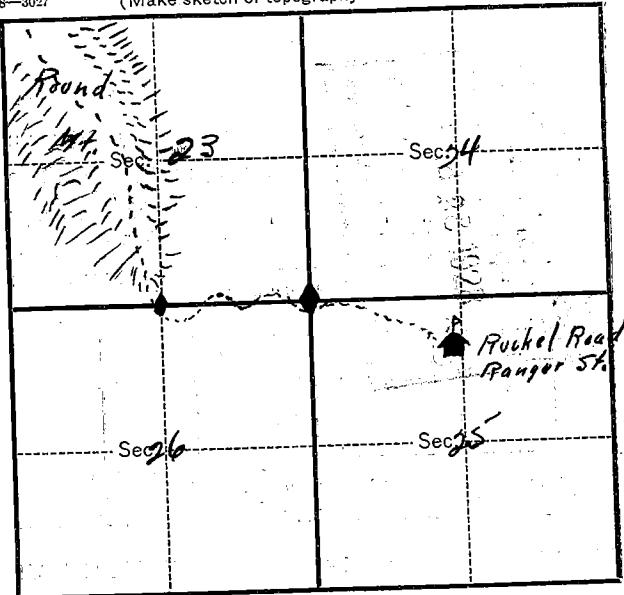

Metal Location Poster is on a Douglas Fir
 tree 24 inches diameter, on the North
 side of Round Mt. Trail
 from which this Corner bears N 84 E
1 ch 6 lks chains distant.


Give any further facts which will aid in finding this
 Corner again.

Metal poster is located on a
Douglas Fir tree 100 yrds. west
of where the Round Mt. Trail
inters the timber in going from
Ruckel Ranger Station to Round
Mt. Tree is about 4 ft. from
the trail.

LAND CORNER RECORD

1. T2N R37E No R-21 Cor. Sec Mer. Will State Oregon (Rectangular) N. F. Umn. Dist. Pend 6

2. Corner Status

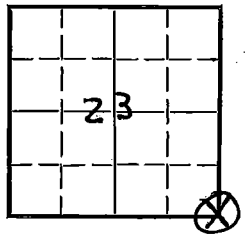

3. Original Description Vol. 454 Page 291 Where Recorded BLM.

4. Description of Corners: Fir Post 4" sq. 3' long 24" in ground
hazel 36" Dia N39E 58 lks
" 18" " S40E 34"
" 24" " S31W 27"
" 38" " N25W 32"

5. Investigation Notes: Fir Post Rotted
Fir 24" N25W 23 ft.
Fir 20" S36W 22 "
Fir 21 1/2" S27E 21 ft. 4"
Fir 33" N36E 31 ft. 8" } Size and species of trees do not agree with original notes. -- bearings & distances a little wild. T&H 3/75
All trees have scribbling showing
Metal tag on Fir 24" Dia S84W 1ch 6lks from corner

7. Photo Identification

Photo No. _____
Ident. By: _____

8. Plane Coordinate Position Data

State _____ Zone _____
X _____
Y _____
Estab. By _____
Field Book No. _____
Where Filed _____

9. Evaluation

Authentic _____
Needs Verif. X Monument NO
Re-estab. _____ Survey _____
Land Status _____

6. Signed Tucher Title D.P. Date Aug 10, 1927 4

PERPETUATION RECORD

10. Monument:

11. Accessories

Field Book _____ Page _____

12. Set By _____ Title _____
License _____ Agency _____ Date _____

13. Recorded By: _____ Volume _____ Page _____
(Agency) _____
(Date) _____ (City) _____ (County) _____ (State) _____

14. Remarks:

R-21