

Index  
File No. V-1

**CORNER RECORD (SEARCH)**


(Ref. FSM 7151.4)

Tract or  
Survey No. \_\_\_\_\_ Cor.  
No. \_\_\_\_\_

T 2N R. 37E R.D. Walla Walla County Umatilla  
Merid. Willamette N.F. Umatilla State Oregon

CORNER DIAGRAM Sec. 31

DESCRIBE CORNER MONUMENT FOUND

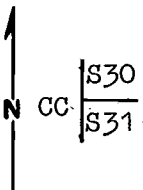

DESCRIBE BEARING TREES OR OTHER OFFICIAL ACCESSORIES FOUND

Orig. 10" Tamarack now 12" S50E-16.5 ft. scribing visible on previously opened blaze.  
Orig. 12" now 18" Tamarack N51E-17.2 ft. scribing visible on previously opened blaze.

PHOTO IDENTIFICATION DATA

Photo No. \_\_\_\_\_  
Filed At. \_\_\_\_\_  
Object Ident. \_\_\_\_\_  
Ident. By \_\_\_\_\_  
*Signature*

DESCRIBE CORNER LOCATION RELATIVE TO NEAR-BY FEATURES, ALSO HOW TO REACH CORNER

From its junction with Rd. #3128 follow Rd. #3128-070 approx. 2 miles to the second logging spur right after crossing East line of Section 36-follow spur North along West side of creek to its end. Corner is North 20° East 400 feet.

PLANE COORDINATE POSITION DATA

State \_\_\_\_\_ Zone \_\_\_\_\_  
X \_\_\_\_\_  
Y \_\_\_\_\_  
Estab. By \_\_\_\_\_  
*Agency*

Signature

*Larry D. Waring*

Title  
Land Surveyor

Division

Headquarters

Date

6/83 7100-52-(3.68)

**CORNER RECORD (PERPETUATION)**

**MONUMENT: DESCRIBE NEW MONUMENT SET, OR WORK DONE TO PRESERVE EXISTING MONUMENT**

Set 2½" x 30" Aluminum pipe with a 2½" Aluminum cap.

**ACCESSORIES : DESCRIBE NEW BT'S WITNESS OBJECTS ETC. ESTABLISHED, OR WORK DONE TO PRESERVE EXISTING EVIDENCE**

Work Done By Larry D. Bishop Title Surveyor Date 6/83 State Registration No. 896  
or Agency

Certified Cor. Record Prepared ? Yes  No  Filed At: \_\_\_\_\_ Date \_\_\_\_\_

**REMARKS**

Set guard post North with signs 54-2 and 54-4.  
Nailed BT and 54-4 signs to BT's as needed and painted band and blazes red.

Index File No. V-1

T.2N

R. 37E

M.

Tract or Surv. No.

Cor. CC

USDA-FOREST SERVICE

Index File No. V-1

CORNER RECORD (SEARCH)

(Ref. FSM 7151.4)

Tract or Survey No. \_\_\_\_\_ Cor. No. \_\_\_\_\_

T 2N R. 37E


R.D. WALLA WALLA County UMATILLA

Merid. WILL

N.F. UMATILLA State OREGON

CORNER DIAGRAM

T2N

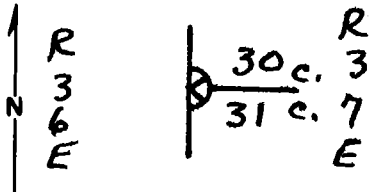

DESCRIBE CORNER MONUMENT FOUND

NONE - ORIGINAL POST IS GONE

DESCRIBE BEARING TREES OR OTHER OFFICIAL ACCESSORIES FOUND

ORIGINAL 10" TAMARACK IS LIVE W/ PREVIOUSLY OPENED BLAZE - SCRIBES VISIBLE. BEARS N51°E, 173 FT. ??

PHOTO IDENTIFICATION DATA

Photo No. \_\_\_\_\_  
 Filed At. \_\_\_\_\_  
 Object Ident. \_\_\_\_\_  
 Ident. By \_\_\_\_\_  
 Signature \_\_\_\_\_

ORIGINAL 10" TAMARACK IS LIVE W/ PREVIOUSLY OPENED BLAZE - SCRIBES VISIBLE. BEARS S50°E, 16.5 FT ?? (RECORD DISTANCES HARD TO READ)

DESCRIBE CORNER LOCATION RELATIVE TO NEAR-BY FEATURES, ALSO HOW TO REACH CORNER

CORNER  $\frac{25}{36}$  IS 53 FT NORTH.

PLANE COORDINATE POSITION DATA

State \_\_\_\_\_ Zone \_\_\_\_\_  
 X \_\_\_\_\_  
 Y \_\_\_\_\_  
 Estab. By \_\_\_\_\_  
 Agency \_\_\_\_\_

Signature

Title

Division

Headquarters

Date

7100-52 (3. 68)

*Dennis L. Gaylord*

PLS 1636

7-15-82

**CORNER RECORD (PERPETUATION)**

**MONUMENT : DESCRIBE NEW MONUMENT SET, OR WORK DONE TO PRESERVE EXISTING MONUMENT**

**ACCESSORIES : DESCRIBE NEW BT'S WITNESS OBJECTS ETC. ESTABLISHED, OR WORK DONE TO PRESERVE EXISTING EVIDENCE**

Work Done By \_\_\_\_\_ Title \_\_\_\_\_ Date \_\_\_\_\_ State Registration No. \_\_\_\_\_  
or Agency \_\_\_\_\_

Certified Cor. Record Prepared ? Yes No Filed At: \_\_\_\_\_ Date \_\_\_\_\_

**REMARKS**

Index File No. T. R. M. Tract or Surv. No. Cor.