

USDA-FOREST SERVICE

Index

File No. A-1

T 1N R. 38E

Merid. Willamette

CORNER RECORD (SEARCH)

(Ref. FSM 7151.4)


R.D. Walla Walla County Union

N.F. Umatilla State Oregon

Tract or
Survey No. _____

Cor.
No. _____

CORNER DIAGRAM

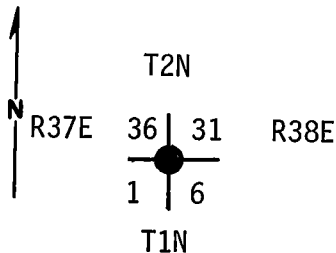

DESCRIBE CORNER MONUMENT FOUND

None.

DESCRIBE BEARING TREES OR OTHER OFFICIAL ACCESSORIES FOUND

We establish the True Corner Point in the following relationship to the remains of the original and resurvey bearing trees: An orig. 10" Fir, now a 38" stump, we open and find good scribing "BT", bears S36°W 42.9 ft., And an orig. 14" Fir, now a stump hole, the tree is completely rotted away, bears S44°E 28.4 ft. A resurvey BT, a 10" Larch, now a 28" White Fir, we open and find scribing "T2", bears N85°W 21.1 ft.

DESCRIBE BEARING TREES OR OTHER OFFICIAL ACCESSORIES FOUND

And a resurvey BT, a 16" Spruce, now a 24" snag, 6 ft. tall, no marks or scars visible bears N60°E 46.2 ft. No trace remains of the original NE and NW bearing trees.

PHOTO IDENTIFICATION DATA

Photo No. F16616160 1577-122A

Filed At. Um. Nat. Forest

Object Ident. Direct

Ident. By G. Langlitz

Signature

PLANE COORDINATE POSITION DATA

State _____ Zone _____

X _____

Y _____

Estab. By _____

Agency

Signature
Gary L. Langlitz

Title
Land Surveyor

Division
PLS 1099

Headquarters


Date
10/2/80

7100-52 (3. 68)

CORNER RECORD (PERPETUATION)

MONUMENT: DESCRIBE NEW MONUMENT SET, OR WORK DONE TO PRESERVE EXISTING MONUMENT

At the True Corner Point, we set a 2"x30" Galvanized Iron Pipe, 26" in the ground on a gentle E slope approx. 30 ft. N of a spring branch, with brass cap attached, marked:

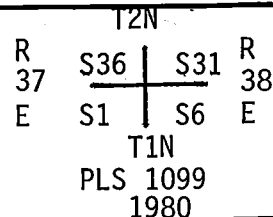

ACCESSORIES: DESCRIBE NEW BT's WITNESS OBJECTS ETC. ESTABLISHED, OR WORK DONE TO PRESERVE EXISTING EVIDENCE

And mark the following new BTs: An 8" White Fir, scribed "T2N R38E S31 BT" on a double blaze bears N47°E 37.3 ft., A 12" White Fir, scribed "T1N R38E S6 BT" on a double blaze bears S71°E 32.0 ft., An 18" Spruce, scribed "T1N R37E S1 BT" on a double blaze bears S11½°W 42.6 ft., and a 12" Spruce scribed "T2N R37E S36 BT" on a double blaze bears N 19°W 38.2 ft. Attached brass washer stamped "LS 1099" to lower blaze of new BTs. Placed steel fence post 5 ft. North of monument with sign 54-4 attached. Attached signs and painted BTs per Standard Specs for Cad. Survey, USFS, Region 6, Oct., 1979.

Work Done By. Gary Langlitz Title Land Surveyor Date 10/2/80 State Registration No. PLS 1099
or Agency

Certified Cor. Record Prepared? Yes No Filed At: Union County Surveyor Date Dec., 1980

REMARKS

Compass Declination: 20° East

Witness: John Curtiss