


CERTIFIED RECORD OF LAND CORNER MONUMENTATION

C - 9
DIAGRAM

History of original corner establishment:

The original corner was established by George S. Pershin on September 9, 1878, under GLO contract No. 293, as follows:

Set a stone, 20" x 9" x 7", on north hillside for 1/4 section corner.

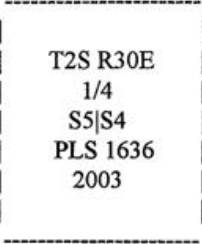

Original corner evidence recovered:

Found the original corner stone loosely set in a mound of stones. The corner stone is 18" x 8" x 6" and is plainly marked "1/4" on one face.

Monument and accessories established to perpetuate the original position of this corner:

In place of the original corner stone, I set a 1" x 30" flared, galvanized iron pipe 19" into the ground to bedrock. A 2 1/2" brass cap attached to the top of the pipe is marked as shown in the diagram above. I bury the corner stone along the north side of the pipe and build a mound of stones around the pipe, from which:

A 5/8" x 36" iron rod set 35" into the ground with a 3/4" brass washer, marked "PLS 1636 NE", attached at ground level, bears N73° 30' E, 58.8 feet.

A 5/8" x 36" iron rod set 35" into the ground with a 3/4" brass washer, marked "PLS 1636 SE", attached at ground level, bears S28° 30' E, 134.9 feet.

A 5/8" x 36" iron rod set 35" into the ground with a 3/4" brass washer, marked "PLS 1636 SW", attached at ground level, bears S47° W, 110.3 feet.


A 5/8" x 36" iron rod set 35" into the ground with a 3/4" brass washer, marked "PLS 1636 NW", attached at ground level, bears N33° W, 129.2 feet.

I nail a "witness post" sign to a wooden fence post 1.3 feet west of the corner.

I hereby certify this corner point was perpetuated as hereon described on February 25, 2003.

Magnetic declination set in compass: 16° E.

NAD '83 UTM Zone 11 position: 5031988N 335386E (plus or minus two meters).

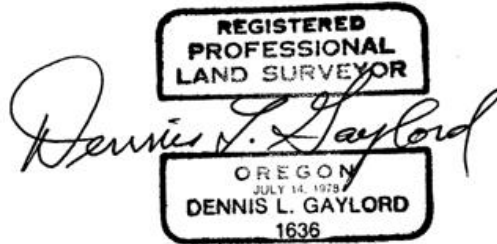

Renews June 30, 2003

Recorded at the office of County Surveyor, County of Umatilla, State of Oregon, on:

RECORDED BY
Umatilla County Surveyor
Date 5-03
Rec'd By AK
No. 03-72-R