


CERTIFIED RECORD OF LAND CORNER MONUMENTATION

Z - 25
DIAGRAM

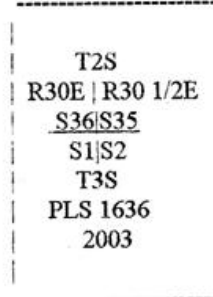

History of original corner establishment:

The original township corner was established by George S. Pershin on October 20, 1871, under joint GLO contract No. 154, as follows:

Set a stone, 20" x 8" x 7", for corner to townships 2 and 3 south, ranges 30 and 31 east. Raised a mound of stone.

This corner was later made a corner to townships 2 and 3 south, ranges 30 and 30 1/2 east, when range 30 1/2 east was created.

Original corner evidence recovered:

Found the original corner stone loosely set in a mound of stones. The corner stone is 22" x 8" x 6" and is plainly marked with six notches on three edges (N, E & W).

Monument and accessories established to perpetuate the original position of this corner:

At the position occupied by the original corner stone, I set a 1" x 18" flared, galvanized iron pipe 15" into the ground to bedrock. A 2 1/2" brass cap attached to the pipe is marked as shown in the diagram above. I bury the corner stone to the west of the pipe, and build a mound of stones around the pipe, from which:

A 5/8" x 24" iron rod set 23" into the ground with a 3/4" brass washer, marked "PLS 1636 35", attached at ground level, bears N42° 30' E, 85.7 feet.

A 5/8" x 24" iron rod set 23" into the ground with a 3/4" brass washer, marked "PLS 1636 S2", attached at ground level, bears S56° E, 97.9 feet.

A 5/8" x 18" iron rod set 17" into the ground with a 3/4" brass washer, marked "PLS 1636 S1", attached at ground level, bears S41° W, 79.0 feet.


A 5/8" x 24" iron rod set 23" into the ground with a 3/4" brass washer, marked "PLS 1636 36", attached at ground level, bears N37° W, 68.9 feet.

I nail a "Witness Post" sign to a wood fence post which bears S64° W, 11.5 feet from the corner. An east - west wire fence bears south, 4.0 feet.

I hereby certify the above corner point was perpetuated as hereon described on May 2, 2003.

Magnetic declination set in compass: 17°E.

NAD '83 UTM Zone 11 position: 5022890N, 341646E (plus or minus 2 meters).

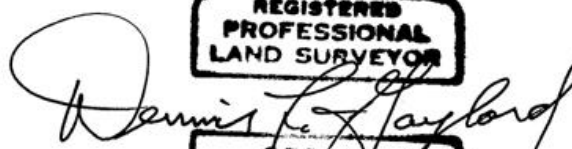
REGISTERED PROFESSIONAL LAND SURVEYOR
 OFF. G.O.W.
 JULY 14, 1978
DENNIS L. GAYLORD
 1636

Renews June 30, 2003

Recorded at the office of County Surveyor, County of Umatilla, State of Oregon, on:

RECEIVED BY
Umatilla County Surveyor
 Date 9-03
 Rec'd By KK
 No. 03-258-R