

OREGON CORNER RESTORATION FORM

Section 3 Township 2S Range 31E
 County Umatilla Date: April 12, 2011

Corner Designation: 2S31C13

Condition Report Only
 Not found
 Remonumented
 Unrecorded
 Surveyed in
 Referenced out

Common quarter corner to sections 3 and 4, T2S, R31E, W.M., Umatilla County, Oregon.


Previous Renewals / Surveys, etc.

Corner originally set by Daniel Chaplin under contract No. 107 dated September 21, 1864. His record reads: Set stone 14x10x6 for 1/4 Sec. Cor.


Monument and Accessories found: (condition and source)

A fence line running north on top of a plow berm approximately 2 feet high. I found fence materials including hand forged square nails approximately 2.5 feet in the ground indicating that the ground had been disturbed below the level of the natural grade at this point.

DIAGRAM

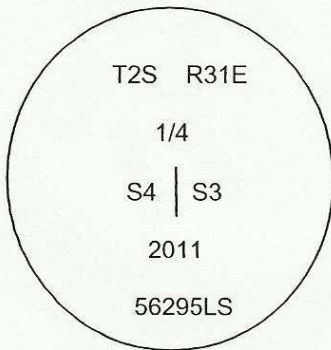

SKETCH

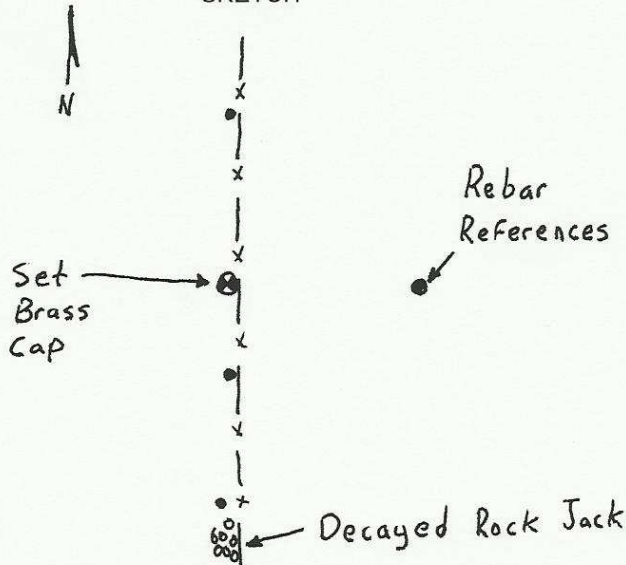

MONUMENT (S) AND ACCESSORIES SET (Procedures and Description)

For this corner I proportioned the latitude and held the long term fence and plow berm for the departure. I set a 2 3/8" brass cap on a 1 1/2"x30" galvanized iron pipe 30 inches in the ground with a small collar of stone around the cap.

For references, I set four 5/8" by 24" rebars with 1.25" orange plastic caps stamped WTS and 56295LS as described below:

- an iron rebar bears N01°12'43"W, 30.48 feet under the fence;
- an iron rebar bears N88°21'41"E, 43.92 feet;
- an iron rebar bears S01°36'03"E, 29.13 feet under the existing fence;
- an iron rebar bears S00°46'56"W, 67.82 feet in a mound of stones from an old rock jack;

The monument and references were tied using a Trimble R7/R8 RTK GPS system.

Location and comments

Compass Declination

Surveyors Seal

RECEIVED BY:
Umatilla County Surveyor
 Date: _____
 Rec'd By: _____
 No. 11-112-C

Firm / Agency
 Witness Tree Surveying
 Address
 P.O. Box G
 Pilot Rock, OR 97868
 Party Chief
 Stephen K, Haddock

REGISTERED
 PROFESSIONAL
 LAND SURVEYOR

Stephen K. Haddock

OREGON
 JULY 9, 2001
 STEPHEN K. HADDOCK
 56295LS

RENEWAL DATE 6-30-13