


CERTIFIED RECORD OF LAND CORNER MONUMENTATION

R - 23

History of original corner establishment:

The original corner was established by Daniel Chaplin on November 18, 1864, under GLO contract No. 107, as follows: Set a stone 15" x 8" x 8" for the 1/4 section corner.

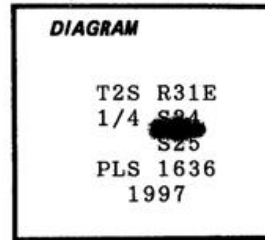

Description of corner evidence found:

A basalt stone, 16" x 11" x 8", lying loose on a mound of stones at the intersection of fences projecting north and east. The stone is plainly marked "1/4".

Description of monument and accessories I established to perpetuate the original location of this corner:

At the corner point as determined by the southwest edge of the stone mound and the intersection of the fences, I set a 1 1/2" x 30" iron pipe 22" into the ground surrounded by a mound of stones. A 2 1/2" brass cap attached is marked as shown in the diagram above. I bury the corner stone along the southeast side of the iron pipe, from which:

A 5/8" x 24" iron rod, set 21" into the ground with a 3/4" brass washer, marked "PLS 1636 S24 NE", attached at ground level, bears N54°E, 66.2 feet.


A 5/8" x 24" iron rod, set 23" into the ground with a 3/4" brass washer, marked "PLS 1636 S25 SE", attached at ground level, bears S34°E, 91.0 feet.

A 5/8" x 24" iron rod, set 24" into the ground with a 3/4" brass washer, marked "PLS 1636 S25 SW", attached at ground level, bears S57°W, 90.5 feet.

A 5/8" x 24" iron rod, set 24" into the ground with a 3/4" brass washer, marked "PLS 1636 S24 NW", attached at ground level, bears N33°W, 108.8 feet.

I hereby certify the above corner point was perpetuated as hereon described on April 7, 1997. Magnetic declination: 20° E.

Witnesses: Milena Gaylord
Jacqueline Franco

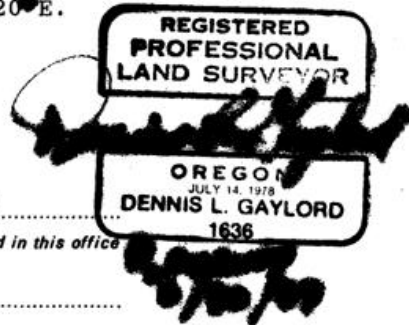

Office of..... County of.....
 State of....., I hereby certify that the within instrument was filed in this office
 for record on the..... day of....., 19.....
 by
 (COUNTY OFFICIAL) (DEPUTY)

Form R6-7100-57 (9/71)

RECEIVED BY
 Umatilla County Surveyor
 Date 4-97
 Rec'd By KK
 No. 97-60-R

GPO-791-311