



History of original corner establishment:
The original corner was established by Daniel Chaplin on November 19, 1864, under GLO contract No. 107, as follows:
Set stone 18" x 14" x 5" for corner to sections 34, 35, 26 and 27.

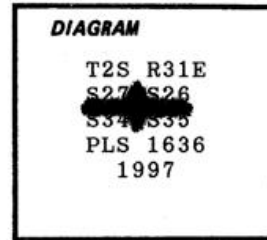

Description of corner evidence found:
The original corner stone is loosely set 4" into the ground and is plainly marked with 2 grooves on the east face. The stone is 16" x 12" x 6". A mound of stones bears North, 3.0 feet.

Description of monument and accessories established to perpetuate the original location of this corner:
In the exact position occupied by the corner stone, I set a 1 1/2" x 30" iron pipe 25" into the ground. I bury the corner stone along the south side of pipe and build a mound of stones around the pipe. A 2 1/2" brass cap attached is marked as shown in the diagram above. The corner is 19 feet north west of a ridge top jeep road. From which:
A 5/8" x 24" iron rod set 23" into the ground with a 3/4" brass washer attached at ground level marked "PLS 1636 S26" bears N63°E, 83.0 feet.
A 5/8" x 24" iron rod set 23" into the ground with a 3/4" brass washer attached at ground level marked "PLS 1636 S35" bears S43 1/2°E, 65.4 feet.
A 5/8" x 24" iron rod set 23" into the ground with a 3/4" brass washer attached at ground level marked "PLS 1636 S34" bears S53°W, 76.1 feet.
A 5/8" x 24" iron rod set 23" into the ground with a 3/4" brass washer attached at ground level marked "PLS 1636 S27" bears N31°W, 79.4 feet.

I hereby certify the above corner was perpetuated as hereon described on February 9, 1997. Magnetic declination: 20°E.

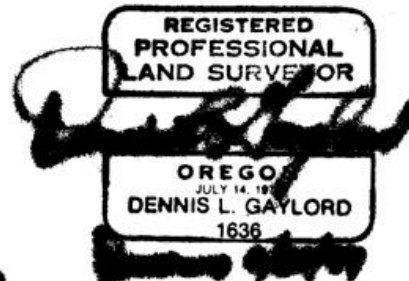

Office of _____ County of _____
State of _____, I hereby certify that the within instrument was filed in this office for record on the 29 day of February, 1997.

(COUNTY OFFICIAL) by _____ (DEPUTY)

Form R6-7100-57 (9/71)

RECEIVED BY
Umatilla County Surveyor
Date 2-97
Rec'd By KK
No. 97-12-R