

OREGON CORNER REFORMATION FORM

G-13

Section 9 Township 2S Range 32E  
 County Umatilla Date: April 25, 1997

Corner Designation: 2S32 G13

1/4 Corner to sections 4 and 9, T2S, R32E W.M.



Condition Report Only  
 Not found  
 Remonumented  
 Unrecorded  
 Surveyed in  
 Referenced out

Previous Renewals / Surveys, etc.

Corner originally set by David P. Thompson under contract No. 106 Dated August 16, 1864.  
 His record reads: Set stone 20 x 8 x 6 for 1/4 section corner.

Monument and Accessories found: ( condition and source )

A stone 20 x 8 x 6 inches was found in a rock jack at a fence corner with fences running South and West. The point lies on the north side of a small saddle in the ridge. There are visible remains of a fence line running North from this point.

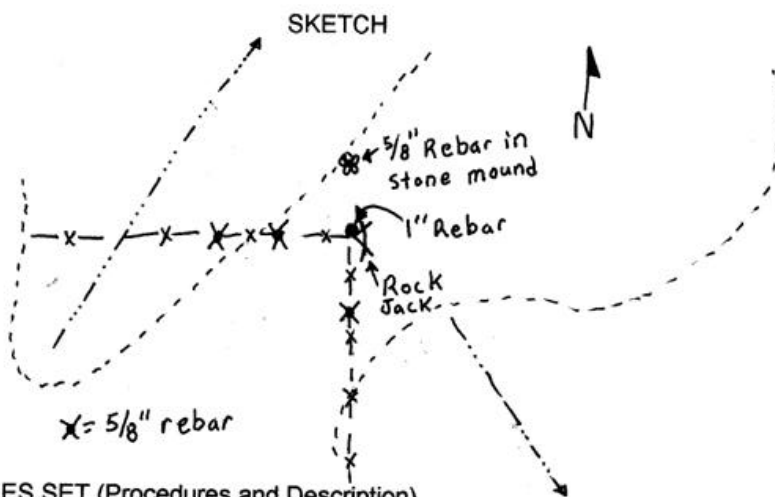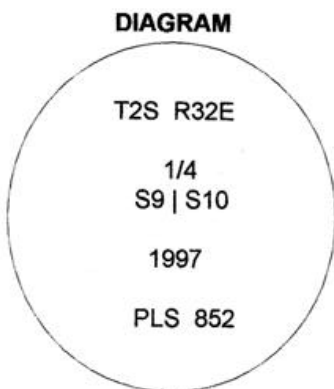

**MONUMENT (S) AND ACCESSORIES SET (Procedures and Description)**  
 Set a 1" by 30" rebar at the fence corner.

For references, I set four 5/8" by 24" rebars with 1.25" red plastic caps stamped ORLS 852 and WALS 13922 as described below:

- a rebar bears S89°46'W, 86.89 feet under the west bound fence;
- a rebar bears S89°49'W, 45.05 feet under the west bound fence;
- a rebar bears N02°03'E, 60.73 feet in a mound of stone;
- a rebar bears S02°53'W, 49.60 feet;

Monument and reference locations were surveyed with GPS receivers in stop and go mode.

The bearings are true. The distances are grid.

Location and comments

Compass Declination

Surveyors Seal

RECEIVED BY:  
Umatilla County Surveyor  
 Date:  
 Rec'd By:  
 No. 97-131-R

Firm / Agency  
 Haddock Surveying  
 Address  
 P.O. Box 1574  
 Pendleton, Or. 97801  
 Party Chief  
 Stephen K, Haddock

REGISTERED  
 PROFESSIONAL  
 LAND SURVEYOR

*David L. Haddock*

OREGON  
 JULY 12, 1906  
 DAVID L. HADDOCK  
 582

RECEIVED BY  
Umatilla County Surveyor  
 Date 7-97  
 Rec'd By SK  
 No. 97-131-R

REFER to 97-109-B