

OREGON CORNER RESTORATION FORM

Section 28 Township 2S Range 32E
 County Umatilla Date: April 5, 2007

Corner Designation: 2S32R13

Corner to sections 21, 22, 27, and 28, T2S, R32E,
 W.M., Umatilla County, Oregon.


Previous Renewals / Surveys, etc.

Corner originally set by Daniel Chaplin under contract No. 107 dated September 21, 1864. His record reads: Set stone, 16 x 10 x 8 for cor. to secs. 21, 22, 27 & 28.


Condition Report Only
 Not found
 Remonumented
 Unrecorded
 Surveyed in
 Referenced out

Monument and Accessories found: (condition and source)

The record dimension basalt stone in the center of a mound of stone on a steep open hillside facing the east. There was no other stone in the area larger than about 6 inches diameter. The stone was unmarked.

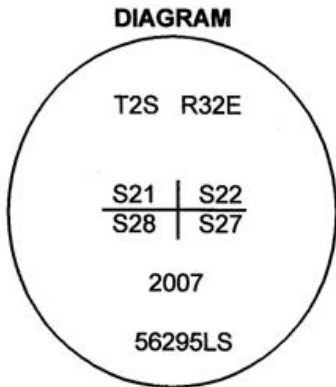

⊙ = 1" Rebar w/ Al. Cap
 ● = Rebar Reference

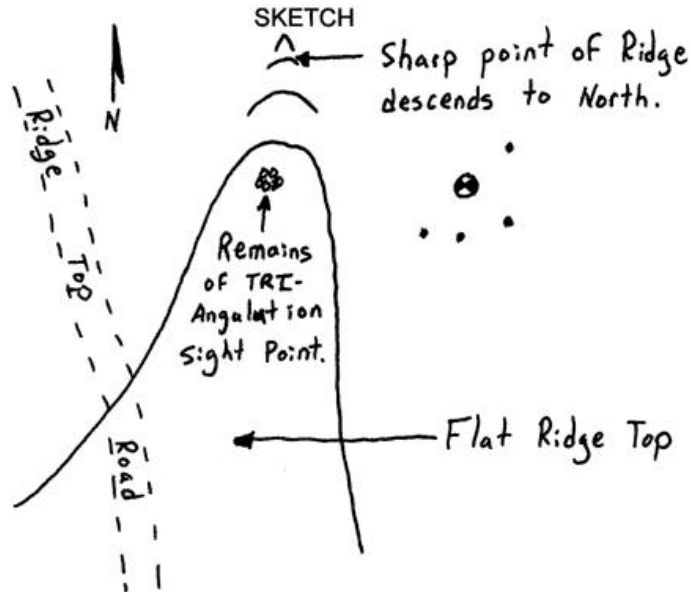

MONUMENT (S) AND ACCESSORIES SET (Procedures and Description)

At the position of the original stone I set a 1" x 24" iron rebar with a 2" aluminum cap stamped as shown in the diagram above. I merely moved the original stone over and left the mound undisturbed when setting the rebar. I did not add any new stones to the mound.

For references, I set four, 5/8" by 24" rebars with 1 1/8" orange plastic caps attached, stamped WTS and 56295LS as described below:

- an iron rebar bears N22°01'50"E, 73.31 feet;
- an iron rebar bears S81°12'48"W, 63.03 feet;
- an iron rebar bears S10°49'28"W, 57.54 feet;
- an iron rebar bears S73°13'13"E, 57.50 feet;

The monument and references were tied using a Trimble R7/R8 RTK GPS.

Location and comments

Compass Declination

Surveyors Seal

RECEIVED BY:
Umatilla County Surveyor
 Date: 6-07
 Rec'd By: KK
 No. 07-169-C

Firm / Agency
 Witness Tree Surveying
 Address
 P.O. Box G
 Pilot Rock, Or. 97868
 Party Chief
 Stephen K, Haddock

REGISTERED
 PROFESSIONAL
 LAND SURVEYOR

Stephen K. Haddock

OREGON
 JULY 9, 2001
 STEPHEN K. HADDOCK
 56295LS

RENEWAL DATE 6-30-07