

OREGON CORNER RESTORATION FORM

Section 29 Township 2S Range 32E
 County Umatilla Date: March 30, 2007

Corner Designation: 2S32R5

Corner to sections 19, 20, 29, and 30, T2S, R32E, W.M., Umatilla County, Oregon.


Condition Report Only
 Not found
 Remonumented
 Unrecorded
 Surveyed in
 Referenced out

Previous Renewals / Surveys, etc.


Corner originally set by Daniel Chaplin under contract No. 107 dated September 21, 1864. His record reads: Set stone, 26 x 15 x 6 for cor. to secs. 19, 20, 29, 30. This corner was re-established by John Arnold in his completion survey under contract No. 551 dated March 19, 1890. His record reads: Finding no trace of old cor., I set, at point of temp Cor. a basalt stone, 14 x 12 x 4 ins., 7 ins. in ground, for Cor. to Secs. 19, 20, 29 & 30, marked 2 notches on S. and 5 notches on E. and raised mound of stone, 2 ft. high x 3 1/2 ft. base over Cor., on S. hillside.

Monument and Accessories found: (condition and source)

The stone by Arnold, loose in a mound of stone approximately 5' diameter, plainly notched as described on the west side of a north - south possessory fence line.

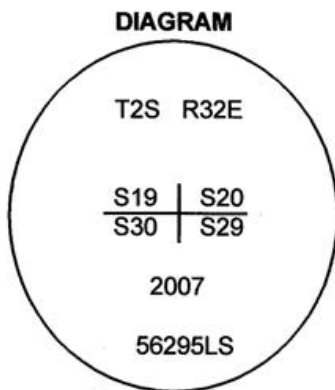

⊙ = Brass Cap
 • = Rebar Reference

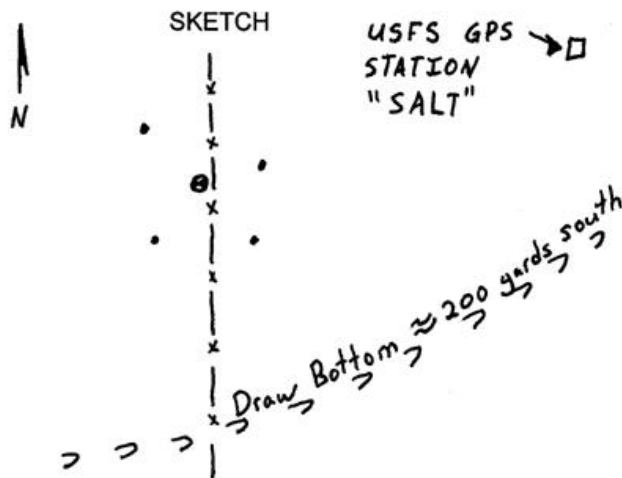

MONUMENT (S) AND ACCESSORIES SET (Procedures and Description)

I set a 1 1/2" x 30" galvanized iron pipe with a 2 1/4" brass cap stamped as shown in the diagram above at the position of the original stone 24" to bedrock. I buried the stone along side and repaired the mound of stone.

For references, I set four, 5/8" by 24" rebars with 1 1/8" orange plastic caps attached, stamped WTS and 56295LS as described below:

- an iron rebar bears N64°20'58"E, 50.14 feet;
- an iron rebar bears N42°08'23"W, 67.61 feet;
- an iron rebar bears S50°53'23"W, 52.74 feet;
- an iron rebar bears S39°49'37"E, 50.00 feet;
- A 3" aluminum cap stamped USFS GPS station "SALT" bears N81°40'06"E, 1496.87 feet;

The monument and references were tied using a Trimble R7/R8 RTK GPS.

Location and comments

Compass Declination

Surveyors Seal

RECEIVED BY:
Umatilla County Surveyor
 Date: 6-07
 Rec'd By: KE
 No. 07-169-C

Firm / Agency
 Witness Tree Surveying
 Address
 P.O. Box G
 Pilot Rock, Or. 97868
 Party Chief
 Stephen K, Haddock

REGISTERED
 PROFESSIONAL
 LAND SURVEYOR

Stephen K. Haddock

OREGON
 JULY 9, 2001
 STEPHEN K. HADDOCK
 56295LS

RENEWAL DATE 6-30-07