

OREGON CORNER RECONSTRUCTION FORM

Section 28 Township 2S Range 32E
 County Umatilla Date: March 29, 2007

Corner Designation: 2S32R9

Condition Report Only
 Not found
 Remonumented
 Unrecorded
 Surveyed in
 Referenced out


Corner to sections 20, 21, 28, and 29, T2S, R32E,
 W.M., Umatilla County, Oregon.

Previous Renewals / Surveys, etc.

Corner originally set by Daniel Chaplin under contract No. 107 dated September 21, 1864. His record reads: Set stone, 20 x 15 x 10 for cor. to secs. 20, 21, 28 & 29.

Monument and Accessories found: (condition and source)

A single basalt stone on an open grassy hillside facing the east. This stone was unmarked but was set as a corner stone should be and was the only stone in the area. It was the record dimensions.

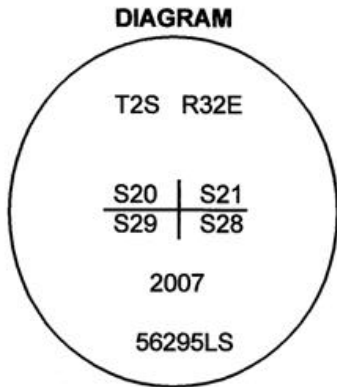

SKETCH

A single Hawthorn Bush

U
 U
 U ← Draw
 U Runs
 U Northerly
 U
 U
 U
 U

⊙ = Brass Cap
 ● = Rebar Reference

MONUMENT (S) AND ACCESSORIES SET (Procedures and Description)

I set a 1 1/2" x 30" galvanized iron pipe with a 2 1/4" brass cap stamped as shown in the diagram above at the position of the original stone. I buried the stone along side and placed a collar of stone around the monument.

For references, I set four, 5/8" by 24" rebars with 1 1/8" orange plastic caps attached, stamped WTS and 56295LS approximately 6" below the surface as described below:

- an iron rebar bears N19°35'29"E, 28.32 feet;
- an iron rebar bears N69°03'21"W, 25.65 feet;
- an iron rebar bears S5°49'56"W, 25.67 feet;
- an iron rebar bears S70°36'34"E, 28.27 feet;

The monument and references were tied using a Trimble R7/R8 RTK GPS.

Location and comments

Compass Declination

Surveyors Seal

RECEIVED BY:
Umatilla County Surveyor
 Date: 6-07
 Rec'd By: KK
 No. 07-169-C

Firm / Agency
 Witness Tree Surveying
 Address
 P.O. Box G
 Pilot Rock, Or. 97868
 Party Chief
 Stephen K, Haddock

REGISTERED
 PROFESSIONAL
 LAND SURVEYOR

Stephen K. Haddock

OREGON
 JULY 9, 2001
 STEPHEN K. HADDOCK
 56295LS

RENEWAL DATE 6-30-07