

**OREGON CORNER RESTORATION FORM**

Section 29 Township 2S Range 32E  
 County Umatilla Date: April 6, 2007

Corner Designation: 2S32T9

Condition Report Only


Quarter corner to sections 28 and 29, T2S, R32E, W.M.  
 Umatilla County, Oregon.

Not found  
 Remonumented  
 Unrecorded  
 Surveyed in  
 Referenced out

Previous Renewals / Surveys, etc.

The corner was originally set by Daniel Chaplin under contract No. 107 dated September 21, 1864. His record reads: Set stone 18 x 14 x 12 for 1/4 sec cor.

Monument and Accessories found: ( condition and source )  
 None.

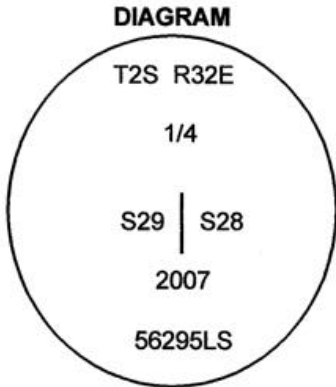

**MONUMENT (S) AND ACCESSORIES SET (Procedures and Description)**

I set a 2 1/4" brass cap on a 1 1/2" x 30" galvanized steel pipe at the proportioned point. The cap was stamped as shown in the diagram above. I made a collar of stone around the cap. For references I set four 5/8" x 24" iron rebars with 1 1/8" orange plastic caps stamped WTS and 56295LS as described below:

- an iron rebar bears N21°24'22"E, 24.13 feet;
- an iron rebar bears S84°06'19"W, 27.88 feet;
- an iron rebar bears S7°19'31"E, 36.86 feet;
- an iron rebar bears S74°29'14"E, 44.86 feet;

These references were set and tied using a Trimble R7/R8 RTK GPS

Location and comments

Compass Declination

Surveyors Seal

RECEIVED BY:  
 Umatilla County Surveyor  
 Date: 6-07  
 Rec'd By: KE  
 No. 07-169-C

Firm / Agency  
 Witness Tree Surveying  
 Address  
 P.O. Box G  
 Pilot Rock, Or. 97868  
 Party Chief  
 Stephen K, Haddock

REGISTERED  
 PROFESSIONAL  
 LAND SURVEYOR

*Stephen K. Haddock*

OREGON  
 JULY 9, 2001  
 STEPHEN K. HADDOCK  
 56295LS

RENEWAL DATE 6-30-07