

OREGON CORNER RESTORATION FORM

Section 17 Township 2S Range 33E
 County Umatilla Date: October 30, 2002

Corner Designation: 2S33J7

Quarter corner common to sections 8 and 17, T2S, R33E, W.M., Umatilla County, Oregon.


Previous Renewals / Surveys, etc.

Corner originally set by John C. Arnold under contract No. 551 dated March 19, 1890.

His record reads: Set basalt stone 12 x 8 x 6 ins., 8 ins. in ground, for 1/4 section corner, marked 1/4 on north face. Raised a mound of stone 2 ft. high x 4 1/2 ft. base over corner on S. hillside.

Monument and Accessories found: (condition and source)

The original stone, loose in a mound of stone, plainly chisled 1/4. Mr. Dennis Gaylord found this monument while performing a water rights application. He stated that he built the mound of stone around the original stone in it's original position.

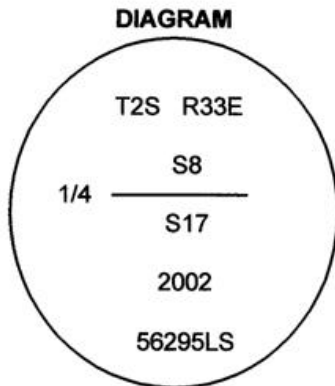

MONUMENT (S) AND ACCESSORIES SET (Procedures and Description)

Set a 1 1/4" x 30" Galvanized Iron Pipe with a 2 1/2" brass cap stamped as shown in the diagram above 26" in the ground. Buried the original stone along the south side. Set a 6' wooden post with a county monument sign attached along side.

For references, I set four 5/8" by 24" rebars with 1.25" orange plastic caps stamped WTS and 56295LS as described below:

- an iron rebar bears N48°12'16"W, 46.38 feet;
- an iron rebar bears N67°50'55"E, 63.42 feet in the top of a small rock outcrop;
- an iron rebar bears S54°26'02"E, 44.42 feet;
- an iron rebar bears S24°41'05"W, 104.74 feet;

The monument and references were tied using a LIECA system 300 RTK GPS.

Location and comments

Compass Declination

Surveyors Seal

RECEIVED BY:
Umatilla County Surveyor
 Date: 2-03
 Rec'd By: KK
 No. 03-24-B

Firm / Agency
 Haddock Surveying
 Address
 P.O. Box 1574
 Pendleton, Or. 97801
 Party Chief
 Stephen K, Haddock

REGISTERED
 PROFESSIONAL
 LAND SURVEYOR

Stephen K. Haddock

OREGON
 JULY 9, 2001
 STEPHEN K. HADDOCK
 56295LS

RENEWAL DATE 6-30-03