

OREGON CORNER RESTORATION FORM

Section 22 Township 2S Range 33E
 County Umatilla Date: June 3, 2000

Corner Designation: 2S33P13

Common quarter corner to sections 21 and 22, T2S, R33E, W.M., Umatilla County, Oregon.

Previous Renewals / Surveys, etc.

Corner originally set by John C. Arnold under contract #551 dated March 19, 1890.

His record reads: Set basalt stone, 18 x 12 x 4 ins., 12 ins. in ground for 1/4 section cor. marked 1/4 on W. face, raised a mound of stone 1 1/2 ft. high by 4 1/2 ft. base over cor. on W. hillside.

Condition Report Only

Not found

x Remonumented



Unrecorded

Surveyed in

x Referenced out

Monument and Accessories found: (condition and source)

The original stone, firmly in place, plainly chisled 1/4. The mound consisted of one other stone.

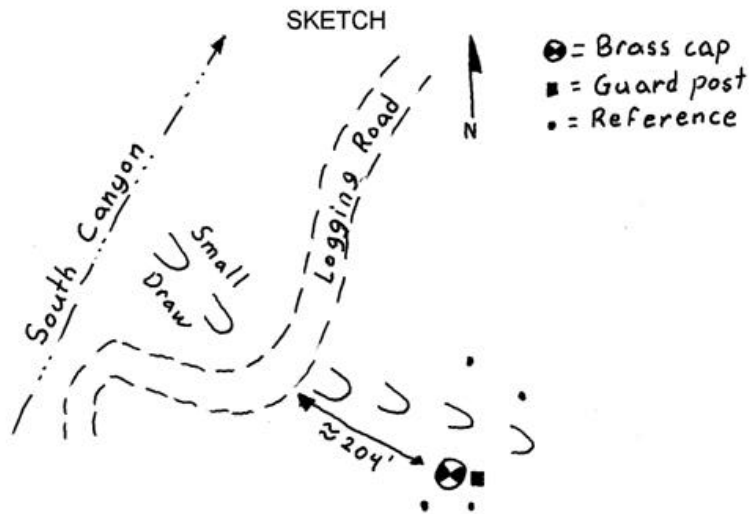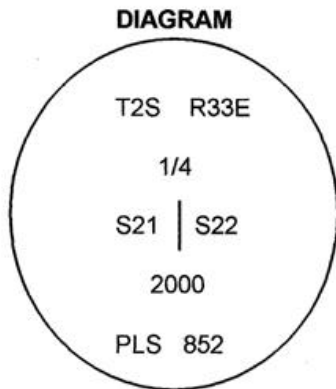

MONUMENT (S) AND ACCESSORIES SET (Procedures and Description)

Set a 1 1/2" x 30" galvanized iron pipe with a 2 1/4" brass cap stamped as shown in the diagram above at the position of the original stone. Buried the stone along side. Set a 6' steel post with a county monument sign attached along side.

For references, I set four 5/8" by 24" rebars with 2.5" red plastic caps stamped ORLS 852, WALSH 13922 and HADDOCK SURVEYING as described below:

- an iron rebar bears N05°02'22"E, 68.16 feet;
- an iron rebar bears N33°53'28"E, 67.98 feet;
- an iron rebar bears S45°07'36"W, 16.46 feet;
- an iron rebar bears S29°08'50"E, 14.90 feet;

The monument and references were tied using a LIECA system 300 RTK GPS.

Location and comments

Compass Declination

Surveyors Seal

RECEIVED BY:
 Umatilla County Surveyor
 Date: 7-20
 Rec'd By: KK
 No. 00-156-C

Firm / Agency
 Haddock Surveying
 Address
 P.O. Box 1574
 Pendleton, Or. 97801
 Party Chief
 Stephen K, Haddock



David L. Haddock

