

OREGON CORNER RESTORATION FORM

Section 23 Township 2S Range 33E
 County Umatilla Date: June 22, 2000

Corner Designation: 2S33P17

Common quarter corner to sections 22 and 23, T2S, R33E, W.M., Umatilla County, Oregon.

	Condition Report Only
	Not found
x	Remonumented
	Unrecorded
	Surveyed in
x	Referenced out

Previous Renewals / Surveys, etc.

Corner originally set by John C. Arnold under contract #551 dated March 19, 1890.



His record reads: Set basalt stone, 14 x 12 x 10 ins., 10 ins. in ground for 1/4 section cor. marked 1/4 on W. face, dug pits 18 x 18 x 12 ins. N. & S of stone, 5 1/5 ft. dist. Raised a mound of stone 2 high x 3 1/2 ft. base over cor., from which:

A fir, 40 ins. diam., brs. S15°E, 39 lks. dist. marked 1/4 S BT;

A fir, 35 ins. diam., brs. S10°W, 25 lks. dist. marked 1/4 S BT;

Monument and Accessories found: (condition and source)

The remains of a N - S fence lie along the line within 20 feet in the E - W direction from a line computed using the calls to Arnolds Peak to the south and the found corners on the north of sections 22 and 23.

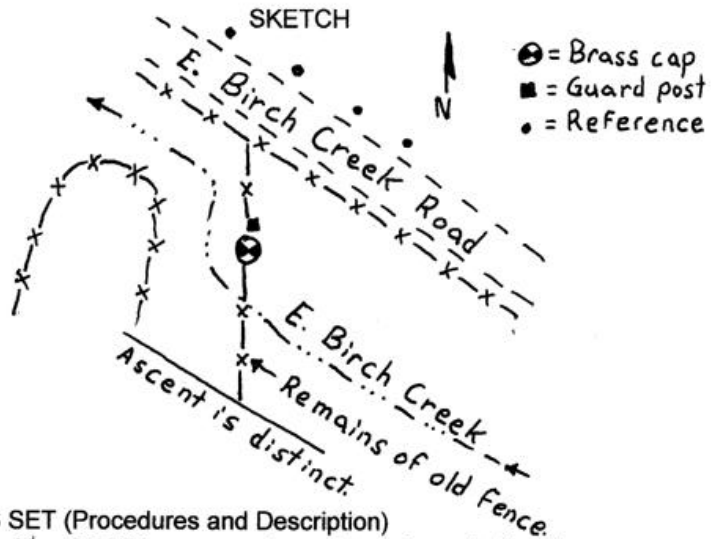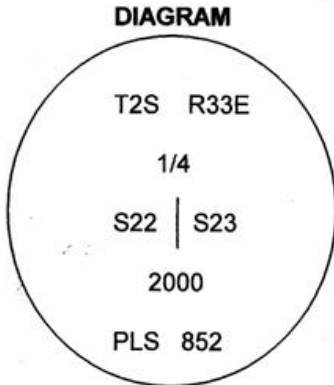

MONUMENT (S) AND ACCESSORIES SET (Procedures and Description)

Set a 1 1/2" x 30" galvanized iron pipe with a 2 1/4" brass cap stamped as shown in the diagram above at the called distance from the ascent along the N - S fence. Set a 6' steel post with a county monument sign attached along side.

For references, I set four 5/8" by 24" rebars with 2.5" red plastic caps stamped ORLS 852, WALSH 13922 and HADDOCK SURVEYING as described below:

- an iron rebar bears N02°41'09"W, 178.61 feet on the north side of the county road;
- an iron rebar bears N06°35'27"E, 162.39 feet on the north side of the county road;
- an iron rebar bears N24°58'03"E, 155.74 feet on the north side of the county road;
- an iron rebar bears N37°51'10"E, 157.99 feet on the north side of the county road;

The monument and references were tied using a LIECA system 300 RTK GPS.

Location and comments

Compass Declination

Surveyors Seal

RECEIVED BY:
Umatilla County Surveyor
 Date: 7-00
 Rec'd By: KK
 No. 00-156-C

Firm / Agency
 Haddock Surveying
 Address
 P.O. Box 1574
 Pendleton, Or. 97801
 Party Chief
 Stephen K, Haddock

