

**OREGON CORNER RESTORATION FORM**

Section 24 Township 2S Range 33E  
 County Umatilla Date: April 21, 2000

Corner Designation: 2S33P25

East quarter corner to section 24, T2S, R33E,  
 W.M., Umatilla County, Oregon.


Condition Report Only  
 Not found  
 Remonumented  
 Unrecorded  
 Surveyed in  
 Referenced out

Previous Renewals / Surveys, etc.

Corner originally set by James P. Currin and James E. Noland under special contract dated May 4, 1887. Their record reads: Set stone, 10 x 8 x 7 ins., 7 ins. in ground for 1/4 section corner marked 1/4 S. on W. face, raised a mound of stone along side from which, A fir, 20 ins. diam., brs. N25°E, 42 lks. dist., marked 1/4 S BT, References to Range 34 East were obliterated and the letters UR added for the Reservation Boundary under the same contract.

Monument and Accessories found: ( condition and source )

A dead fir snag, 34" dbh, with a rotted face, grown over axe marks and blue paint visible inside. The record unmarked stone in a mound of stone at the proper bearing and distance. The stone was also painted blue on top.

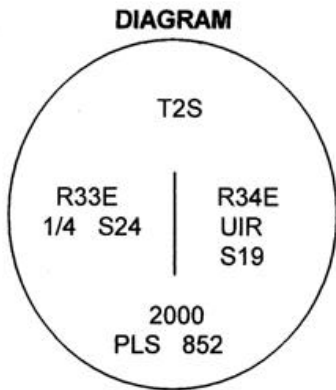

The sketch shows a 'Ridge top with dirt road' at the bottom. A north arrow points upwards. A '34" DBH dead fir' is marked with a circle containing a cross. A distance of '≈ 600'' is indicated between the ridge and the monument. A legend indicates: a circle with a cross is a 'Brass cap', a square is a 'Guard Post', and a dot is a 'Reference'. A dashed line with arrows is labeled 'Draw'.

MONUMENT (S) AND ACCESSORIES SET (Procedures and Description)

Set a 1 1/4" x 30" Galvanized Iron Pipe with a 2 1/2" brass cap stamped as shown in the diagram above in the original mound. Buried the stone along side. Set a 6' steel post with a county monument sign attached along side.

For references, I set four 5/8" by 24" rebars with 1.25" red plastic caps stamped ORLS 852 and WALS 13922 as described below:

- an iron rebar bears N40°32'05"W, 16.69 feet;
- an iron rebar bears N67°47'04"E, 15.99 feet;
- an iron rebar bears S05°23'43"E, 21.23 feet;
- an iron rebar bears S45°23'24"W, 22.05 feet;

The monument and references were tied using a LIECA system 300 RTK GPS.

Location and comments

Compass Declination

Surveyors Seal

RECEIVED BY:  
 Umatilla County Surveyor  
 Date: 7-00  
 Rec'd By: KK  
 No. 00-156-C

Firm / Agency  
 Haddock Surveying  
 Address  
 P.O. Box 1574  
 Pendleton, Or. 97801  
 Party Chief  
 Stephen K, Haddock

REGISTERED  
 PROFESSIONAL  
 LAND SURVEYOR

*David L. Haddock*

OREGON  
 JULY 12, 1900  
 DAVID L. HADDOCK  
 852