

**OREGON CORNER STORAGE FORM**

Section 22 Township 2S Range 33E  
 County Umatilla Date: June 11, 2000

Corner Designation: 2S33R15



Common quarter corner to sections 22 and 27, T2S, R33E,  
 W.M., Umatilla County, Oregon.

Condition Report Only  
 Not found  
 Remonumented  
 Unrecorded  
 Surveyed in  
 Referenced out

Previous Renewals / Surveys, etc.

Corner originally set by John C. Arnold under contract #551 dated March 19, 1890.  
 His record reads: Set basalt stone, 12 x 8 x 6 ins., 8 ins. in ground for 1/4 section cor. marked 1/4 on N. face, dug pits 18 x 18 x 12 ins. E. and W. of stone 5 1/2 ft. dist. . Raised a mound of earth 2 ft. high x 4 1/2 ft. base over corner on N. hillside.

Monument and Accessories found: ( condition and source )  
 The original stone plainly chisled 1/4 and firmly in place on a north hillside.

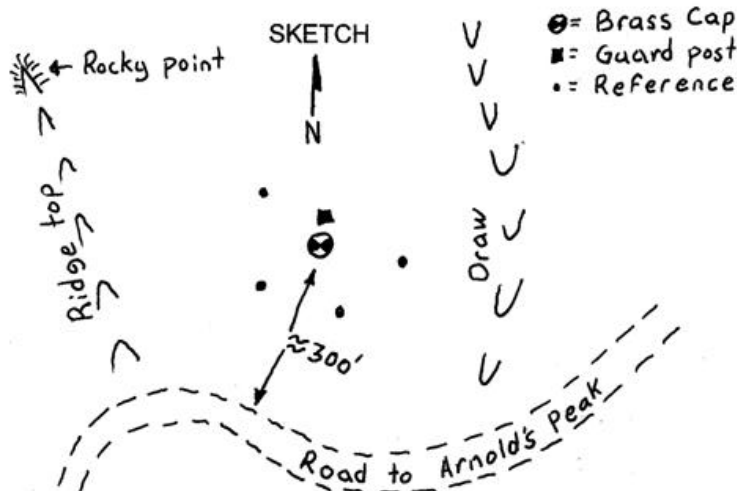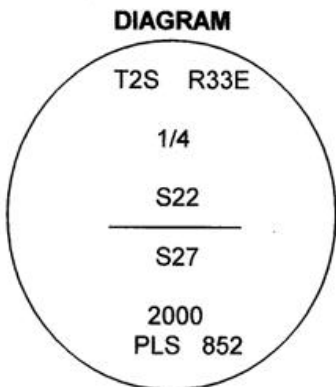

**MONUMENT (S) AND ACCESSORIES SET (Procedures and Description)**

Set a 1 1/2" x 30" galvanized iron pipe with a 2 1/4" brass cap stamped as shown in the diagram above at the position of the original stone. Buried the stone along side. Set a 6' steel post with a county monument sign attached along side.

For references, I set four 5/8" by 24" rebars with 2.5" red plastic caps stamped ORLS 852, WALS 13922 and HADDOCK SURVEYING as described below:

- an iron rebar bears N56°55'12"W, 22.12 feet;
- an iron rebar bears S81°18'16"E, 25.04 feet;
- an iron rebar bears S12°27'59"E, 24.90 feet;
- an iron rebar bears S54°39'02"W, 21.65 feet;

The monument and references were tied using a LIECA system 300 RTK GPS.

Location and comments

Compass Declination

Surveyors Seal

RECEIVED BY:  
 Umatilla County Surveyor  
 Date: 7-00  
 Rec'd By: KK  
 No. 00-156-C

Firm / Agency  
 Haddock Surveying  
 Address  
 P.O. Box 1574  
 Pendleton, Or. 97801  
 Party Chief  
 Stephen K, Haddock

