

**OREGON CORNER RESTORATION FORM**

Section 25 Township 2S Range 33E  
 County Umatilla Date: April 26, 2000

Corner Designation: 2S33R21

Corner to sections 23, 24, 25, and 26, T2S, R33E,  
 W.M., Umatilla County, Oregon.


Condition Report Only  
 Not found  
 Remonumented  
 Unrecorded  
 Surveyed in  
 Referenced out

Previous Renewals / Surveys, etc.

Corner originally set by John C. Arnold under contract #551 dated March 19, 1890.  
 His record reads: A basalt stone, in place, 24 x 12 x 12 ins. above ground for cor. to secs. 23, 24,  
 25 and 26, marked with 4 notches on N. and 2 notches on E. edges. A cross (X) at exact point in  
 a brushy ravine. from which:  
 A willow, 4 ins. diam. brs. S70°E, 17 lks. dist., marked T2S, R33E, S25BT;  
 A willow, 3 1/2 ins. diam. brs. S15°W, 17 lks. dist., marked T2S, R33E, S26BT;  
 A willow, 3 ins. diam. brs. N15°W, 10 lks. dist., marked T2S, R33E, S23BT;  
 Made a mound of stone 1 1/5 ft. high by 3 1/2 ft. base in section 24, 5 1/2 ft. dist.

Monument and Accessories found: ( condition and source )

A north - south fence and a ravine with a distinct bottom. Two approximately 1' diameter willows  
 rotted and down with visible axe marks.

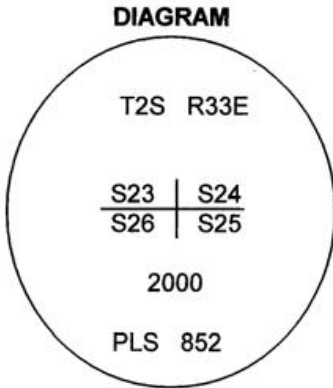

**MONUMENT (S) AND ACCESSORIES SET (Procedures and Description)**

Set a 1 1/2" x 30" galvanized iron pipe with a 2 1/4" brass cap stamped as shown in the diagram  
 above at the intersection of the ravine and the N - S fence. Set a 6' steel post with a county  
 monument sign attached along side. The axe marks on the willows was fairly recent and there  
 was no evidence of scribing.

For references, I set four, 5/8" by 24" rebars with 1.25" red plastic caps stamped ORLS 852 and  
 WAL5 13922 as described below:

- an iron rebar bears N41°25'28"W, 42.31 feet;
- an iron rebar bears N46°03'45"E, 19.37 feet;
- an iron rebar bears S52°39'00"W, 26.35 feet;
- an iron rebar bears S08°47'11"E, 18.28 feet;

The monument and references were tied using a LIECA system 300 RTK GPS.

Location and comments

Compass Declination

Surveyors Seal

RECEIVED BY:  
Umatilla County Surveyor  
 Date: 7-00  
 Rec'd By: KK  
 No. 00-156-C

Firm / Agency  
 Haddock Surveying  
 Address  
 P.O. Box 1574  
 Pendleton, Or. 97801  
 Party Chief  
 Stephen K, Haddock

