

OREGON CORNER RESTORATION FORM

Section 36 Township 2S Range 33E
 County Umatilla Date: April 19, 2000

Corner Designation: 2S33X25

East quarter corner to section 36, T2S, R33E, W.M., Umatilla County, Oregon.



Condition Report Only
 Not found
 Remonumented
 Unrecorded
 Surveyed in
 Referenced out

Previous Renewals / Surveys, etc.

Corner originally set by James P. Currin and James E. Noland under special contract dated May 4, 1887. Their record reads: A spruce, 8 ins. diam., which I marked 1/4 S on W. face for 1/4 section corner from which,
 A spruce, 8 ins. diam., brs. N30°E, 13 lks. dist., marked 1/4 S BT,
 A spruce, 6 ins. diam., brs. S85°W, 19 lks. dist., marked 1/4 S BT,
 References to Range 34 East were obliterated and the letters UR added for the Reservation Boundary under the same contract.

Monument and Accessories found: (condition and source)

A spruce snag with the BT scribing plainly visible was lying on the ground next to it's stump which had the regrowth around the original blaze still intact and in place. The stump of the original corner was badly decayed with no visible scribing but it's location was identifiable.

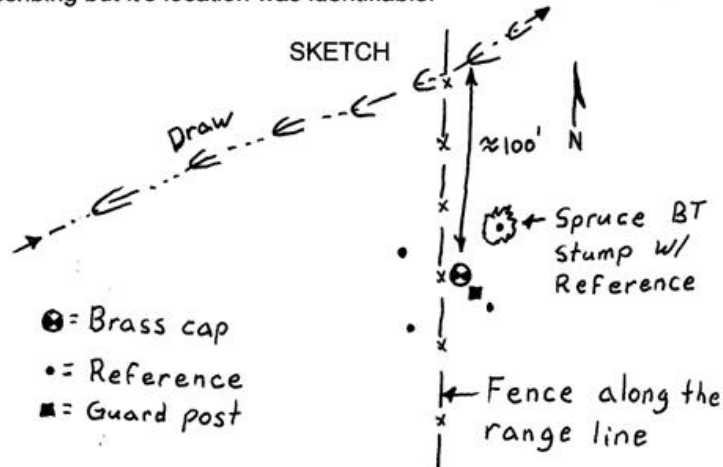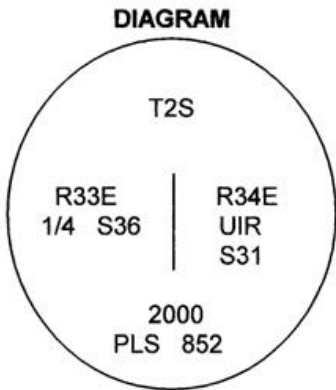

MONUMENT (S) AND ACCESSORIES SET (Procedures and Description)

Set a 1 1/4" x 30" Galvanized Iron Pipe with a 2 1/2" brass cap stamped as shown in the diagram above in the original stump with a collar of stone. Set a 6' steel post with a county monument sign attached along side.

For references, I set four 5/8" by 24" rebars with 1.25" red plastic caps stamped ORLS 852 and WALS 13922 as described below:

- an iron rebar bears N51°51'49"W, 24.87 feet;
- an iron rebar bears N26°00'37"E, 8.49 feet in the existing BT stump;
- an iron rebar bears S50°58'47"E, 21.61 feet;
- an iron rebar bears S44°56'20"W, 23.12 feet;

The monument and references were tied using a LIECA system 300 RTK GPS.

Location and comments

Compass Declination

Surveyors Seal

RECEIVED BY:
 Umatilla County Surveyor
 Date: 7-20
 Rec'd By: KK
 No. 00-156-C

Firm / Agency
 Haddock Surveying
 Address
 P.O. Box 1574
 Pendleton, Or. 97801
 Party Chief
 Stephen K, Haddock

