


History of original corner establishment:

The original corner was established by Jacob C. Cooper under contract number 397 on August 24, 1881, as follows:
Set a post for the corner, from which:
A 5" fir bears N37°W, 18 links (11.88 feet).
A 46" pine bears N43°E, 70 links (46.2 feet).

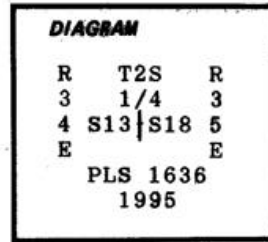

On September 7, 1917, L. E. Wilkes perpetuated the corner point under group number 29 by setting a 1" x 36" iron pipe with a brass cap attached marked "1/4 S13 | S18 1917", from which:
A 15" fir marked "1/4S" with lower blaze healed over (original BT) bears N45°45'W, 18 links.
A 48" pine marked "1/4S BT" (original BT) bears N44°20'E, 70 links.

Description of corner evidence found:

I find the 1917 iron pipe buried 8", bent double and damaged beyond use, but the base is solidly set in place. The attached brass cap is marked "1/4 S13 | S18 1917", from which:

A 17" Douglas-fir with scribes "1/4 S" visible on previously opened upper blaze, lower blaze healed over, bears N40°W, 11.9 feet.

A 42" sawn and burnt pine stump, no marks remain, bears N47°E, 46.2 feet.


Description of monument and accessories established to perpetuate the original location of this corner:

Moving the 1917 iron pipe aside, I set in it's place a 1" x 30" iron pipe 28" into the ground. A 2 1/2" brass cap attached is marked as shown in the diagram above. I bury the 1917 monument horizontally alongside the new monument. From which:

- A 9" Ponderosa Pine, scribed "1/4 S18 BT", bears N56°E, 35.3 feet.
 - A 10" Ponderosa Pine, scribed "1/4 S18 BT", bears S51°E, 68.1 feet.
 - A 12" Ponderosa Pine, scribed "1/4 S13 BT", bears S12°1/2 W, 35.6 feet.
 - A 21" Ponderosa Pine, scribed "1/4 S13 BT", bears N72°W, 14.1 feet.
- The two new bearing trees to the south are south of the Johnson Ridge road. The corner is 18 feet north of the centerline of the Johnson Ridge road.

Each of the new bearing trees is scribed on double blazes, has a 5/8" brass washer, marked "PLS 1636", nailed flush to the lower blaze and a bearing tree sign nailed above the blazes.

I hereby certify the above corner point was perpetuated as hereon described on October 29, 1995. Magnetic declination: 20° E.

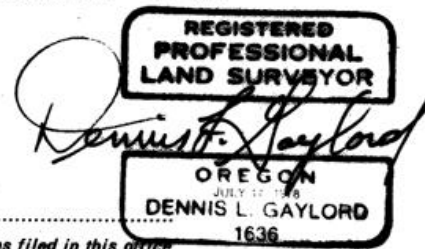

Office of..... County of.....
State of....., I hereby certify that the within instrument was filed in this office for record on the..... day of....., 19....
..... by
(COUNTY OFFICIAL) (DEPUTY)

L-1

RECEIVED BY
Umatilla County Surveyor
Date 11-95
Rec'd By KK
No. 95-193-R