

**OREGON CORNER RESTORATION FORM**

Section 19 Township 2S Range 34E  
 County Umatilla Date: June 27th, 2006

Corner Designation: 2S34N3

Quarter corner common to sections 18 and 19, T2S, R34E, W.M., Umatilla County, Oregon.


Condition Report Only  
 Not found  
 Remonumented  
 Unrecorded  
 Surveyed in  
 Referenced out

Previous Renewals / Surveys, etc.


Corner originally set by James Currin and James Noland under special instruction dated May 4th, 1887. Their record reads: Set stone, 6 x 8 x 14 ins., 8 ins. in ground, for 1/4 sec. cor., marked 1/4 on N. face, around which, I erected mound of stone, 18 ins. high with 3 1/2 foot base.

Monument and Accessories found: ( condition and source )

I found the original basalt stone, in place, poorly marked, in a mound of stone near the correct distance east of the gulch. The stone was the record size.

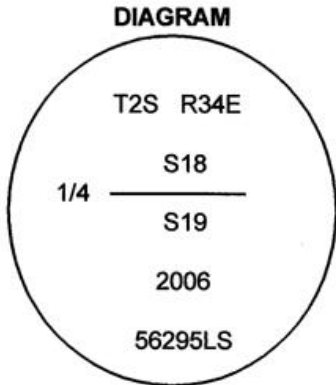

⊙ = Brass Cap  
 ● = Rebar Reference

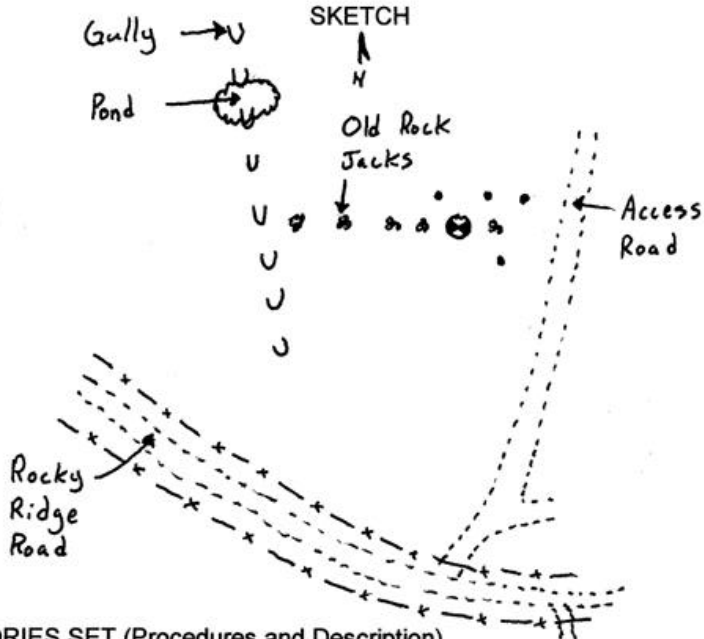

**MONUMENT (S) AND ACCESSORIES SET (Procedures and Description)**

At the position of the original stone I set a 1 1/2" x 30" galvanized iron pipe with a 2 1/4" brass cap attached, 24 inches in the ground to bedrock. I buried the original stone along side and made a small mound of stone and dirt around the cap. The cap was stamped as shown in the diagram above.

For references, I set four 5/8" by 24" rebars with 1.25" orange plastic caps stamped WTS and 56295LS as described below:

- an iron rebar bears N65°37'23"W, 23.50 feet;
- an iron rebar bears N25°14'40"E, 29.49 feet;
- an iron rebar bears N85°37'28"E, 71.36 feet;
- an iron rebar bears S55°56'25"E, 74.19 feet;

The monument and references were tied using a Trimble R7/R8 RTK GPS.

Location and comments

Compass Declination

Surveyors Seal

RECEIVED BY:  
 Umatilla County Surveyor  
 Date: 7-06  
 Rec'd By: KK  
 No. 06-491-B

Firm / Agency  
 Witness Tree Surveying  
 Address  
 P.O. Box G  
 Pilot Rock, Or. 97868  
 Party Chief  
 Stephen K, Haddock

REGISTERED  
 PROFESSIONAL  
 LAND SURVEYOR

*Stephen K. Haddock*

OREGON  
 JULY 9, 2001  
 STEPHEN K. HADDOCK  
 56295LS

RENEWAL DATE 6-30-07