

Index

File No. X-Y-1

T 2S R.33 1/2E-34E

Merid. Willamette

**CORNER RECORD (SEARCH)**

(Ref. FSM 7151.4)

R.D. La Grande County Union

N.F. Wallowa-Whitman State Oregon

Tract or  
Survey No. \_\_\_\_\_

Cor.  
No. M.P.


**CORNER DIAGRAM**

**DESCRIBE CORNER MONUMENT FOUND**

Found 2" iron pipe and brass cap projecting 12" above the ground.

**DESCRIBE BEARING TREES OR OTHER OFFICIAL ACCESSORIES FOUND**

**DESCRIBE CORNER LOCATION RELATIVE TO NEAR-BY FEATURES, ALSO HOW TO REACH CORNER**

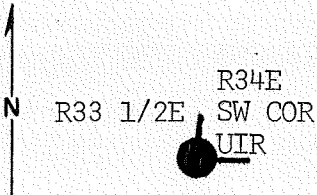

**PHOTO IDENTIFICATION DATA**

Photo No. \_\_\_\_\_

Filed At. \_\_\_\_\_

Object Ident. \_\_\_\_\_

Ident. By \_\_\_\_\_

*Signature*

**PLANE COORDINATE POSITION DATA**

State \_\_\_\_\_ Zone \_\_\_\_\_

X \_\_\_\_\_

Y \_\_\_\_\_

Estab. By \_\_\_\_\_

*Agency*

*Signature*

*Barry B. Barbaw*

P. Title  
*F. L. S.*

Division

Headquarters

*Smelter*

Date  
*11-6-80*

7100-52 (3. 68)

**CORNER RECORD (PERPETUATION)**

**MONUMENT: DESCRIBE NEW MONUMENT SET, OR WORK DONE TO PRESERVE EXISTING MONUMENT**

Found 2" iron pipe and brass cap projecting 12" above the ground. Marked: Pipe loose. Removed one foot of duff/ replaced with dirt. Built mound of stone around to cap.

T2S  
R34E  
R33 1/2E SW COR  
UIR

**ACCESSORIES : DESCRIBE NEW BT'S WITNESS OBJECTS ETC. ESTABLISHED, OR WORK DONE TO PRESERVE EXISTING EVIDENCE**

From which by magnetic declination of N20°E; A 30" pine bears N50°W, 18.2 ft. open blazes and visible scribing. A 15" fir bears N45°E, 32.7 ft. with grown over blazes. Painted 6" red band around. Placed 54-2s and 54-4s. Placed 54-2 and 54-4 on steel fence post 5' south of the corner.

Work Done By B. B. Barbour Title P.L.S. Date 11-6-80 State Registration No. OR 1051  
or Agency

Certified Cor. Record Prepared ? Yes  No  Filed At: Union County Surveyor's Date

**REMARKS**

Witnesses: Daniel Rowland  
Doug Moser  
Ron Gilroy

Index File No. T. R. M. Tract or Surv. No. Cor.