

Form 874-9—Revised May, 1916 *already found*

U. S. DEPARTMENT OF AGRICULTURE  
FOREST SERVICE

Umatilla NATIONAL FOREST

CORNERS OF THE PUBLIC SURVEY

T. R. S. R. 35 E. W. Mer.

Section Corner common to Sections

29, 30, 31, and 32

Corner consists of a Stake (not) in place

State condition Almost rotted away

Dimensions above ground 3x3x15 inches.

Sketch grooves, letters, figures, or notches, on proper face or edge.

CARDINAL POSITION

DIAGONAL POSITION

N	W	S	E

<u>T28</u>		<u>S</u>	
<u>R35</u>	<u>31</u>	<u>32</u>	
<u>E</u>			
NW	SW	SE	NE

Mound of \_\_\_\_\_ is located \_\_\_\_\_

Pits are located \_\_\_\_\_

Sketch markings of Bearing Trees (or Rocks) in proper box and fill blanks below, giving bearings from Corner to Trees and Distances in Links.

<u>2 S</u>
<u>R35 E</u>
<u>S</u>

<u>35 E</u>
<u>S 31</u>

--

<u>Dead</u>
<u>R35 E</u>
<u>S 29</u>

<u>BT</u>
-----------

--

--

<u>BT</u>
-----------

Species Larch DF Larch  
 Diameter 15 in. 14 in. 10 in.  
 Bearing N. 27° W. S. 19° 30' W. N. 22° 30' E.  
 Distance 42 ft. 46 ft. 8 ft.

Do you believe this to be a genuine Land Office Corner? Yes

If not, why? \_\_\_\_\_

\_\_\_\_\_

Gould J. Tucker  
Signature.


9-10-35  
Date.

Forest Ranger  
Title

T. 2 S R. 35 E W Mer.

8-3027

(Make sketch of topography near Corner.)

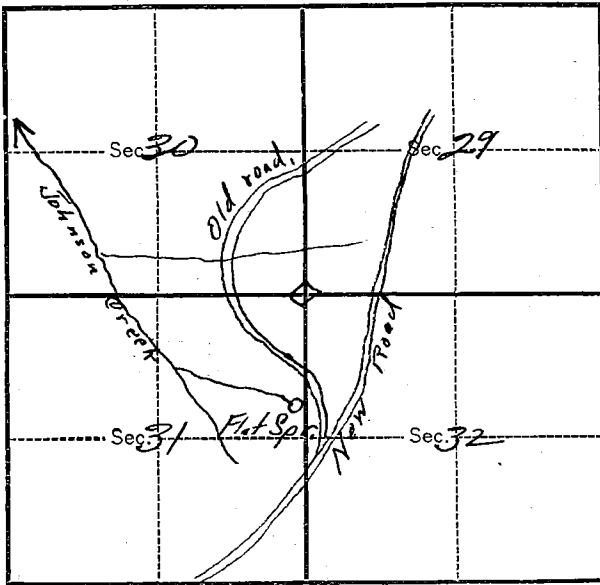

Metal Location Poster is on a Larch  
 tree 16 inches diameter, on the South  
 side of corner  
 from which this Corner bears 54  
chains distant.

Give any further facts which will aid in finding this  
 Corner again.

Section line marked as new  
road about 1/4 mi north east  
of Flat Sp.