

USDA-FOREST SERVICE

Index

File No. Z-9

CORNER RECORD (SEARCH)

(Ref. FSM 7151.4)

Tract or

Survey No.

No. Z-9

T 1S R. 36E

R.D. Pendleton


County Umatilla & Union

Merid. Willamette

N.F. Umatilla

State Oregon

CORNER DIAGRAM

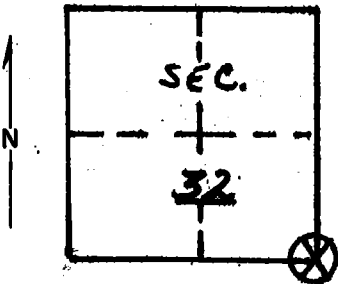

DESCRIBE CORNER MONUMENT FOUND

Material: Steel fence post.

Height Above Ground: 24"

Markings: BLM location poster wired to top of post - 3 stones at base.

DESCRIBE BEARING TREES OR OTHER OFFICIAL ACCESSORIES FOUND

26" p. pine - S.69E. - 8' dist. blazed NW face, scribed: R.36E., S4 with F.S. location and ~~boundary~~ ^{bearing} tree posters on it. Bearing trees in SW and NW quadrants down but have attention and B.T. posters on them. No evidence in NE quadrant. ~~(X Ref.)~~

PHOTO IDENTIFICATION DATA

Photo No. _____

Filed At. _____

Object Ident. _____

Ident. By _____

Signature. _____

PLANE COORDINATE POSITION DATA

State _____ Zone _____

X _____

Y _____

Estab. By _____

Agency _____

Signature

Bill Moore

Title

Eng, Tech,

Division

Headquarters

Date

9/9/77

7100-52-(3/68)

CORNER RECORD (PERPETUATION)

GPO 902-679

MONUMENT: DESCRIBE NEW MONUMENT SET, OR WORK DONE TO PRESERVE EXISTING MONUMENT

9

ACCESSORIES: DESCRIBE NEW BT'S WITNESS OBJECTS ETC. ESTABLISHED, OR WORK DONE TO PRESERVE EXISTING EVIDENCE

10

Work Done By _____ Title _____ Date _____ State Registration No. or Agency _____

Certified Cor. Record Prepared? Yes No Filed At: _____ Date _____

11

REMARKS

12

Index File No. T. R. M. Tract or Surv. No. Cor. _____

13