

OREGON CORNER RESTORATION FORM

COUNTY: Umatilla DATE: May 24, 2005

CORNER DESIGNATION: Z-25 SE Corner Section 36, T. 4 North, Range 27 E.W.M.


PREVIOUS RENEWALS/SURVEYS ETC.

See Remonumentation Sheet 03-49-G by PLS48509

MONUMENT AND ACCESSORIES FOUND:

Found a 2 1/2" brass cap approximately 15" deep on April 5, 2005. The brass cap is now 17" below the surface of a new A.C. overlay. The accessories shown by PLS48509 on 03-49-G are still intact, but were not tied.

MONUMENT MARKING DETAIL

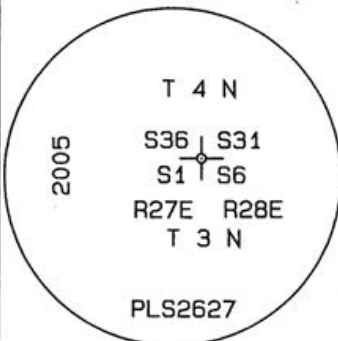

OREGON STATE PLANE COORDINATES,
NORTH ZONE, NAD '83 ('91), INT. FEET:
NORTH: 771591.89 (771591.93, RECORD, 03-49-G)
EAST: 8489766.86 (8489766.84, RECORD, 03-49-G)

MONUMENT SET (PROCEDURES AND DESCRIPTION):
Prior to road reconstruction, Krumbein's brass cap was tied from GPS Station 0614, a 5/8" iron rebar with yellow plastic cap set by Caswell, Survey No. 94-171-G. After road reconstruction was completed, set a 5/8" X 12" iron rebar with 2" aluminum cap marked as shown in monument marking detail flush with asphalt road surface.

NEW ACCESSORIES:

None

LOCATION AND COMMENTS:
From the intersection of Colonel Jordan Road and Noble Road, travel south on Colonel Jordan Road for 1/2 mile. The monument is set flush with the new asphalt surface.
COMPASS DECLINATION:
N/A

FIRM/AGENCY:
Umatilla County Road Dept.
3920 Westgate
Pendleton, Oregon 97801

PARTY CHIEF:
Gary Roberts

NOTES:

WITNESS:

SURVEYOR'S SEAL

REGISTERED
PROFESSIONAL
LAND SURVEYOR

Day R. Roberts
OREGON
JULY 30, 1993
GARY R. ROBERTS
2627

RENEWS 12/31/06

RECEIVED BY

Umatilla County Surveyor

Date 5-05

Rec'd By KK

No. 05-115-R