

# OREGON CORNER RESTORATION FORM

Section 3 Township 3N Range 27E  
 County Umatilla Date: 06-14-02

Corner Designation: 3N27E13

_____x_____	Condition Report Only
_____	Not Found
_____	Remonumented
_____	Unrecorded
_____x_____	Surveyed In
_____	Referenced Out


Previous Renewals / Surveys, etc.

Survey Q-573-B records finding a brass cap at this corner.


Monument and Accessories Found: ( condition and source )

Found the monument and accessories described below in good condition.

DIAGRAM

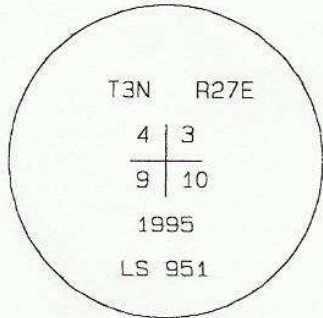

SKETCH

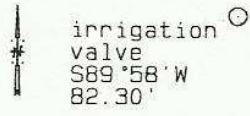

MONUMENT (S) AND ACCESSORIES SET (Procedures and Description)

None.

REFERENCES SET:

None.

Made GPS tie to TRI Station Stanfield East Base.	Oregon State Plane Coord. - North Zone
Latitude <u>45°45'45.58789"N</u>	Northing <u>765952.08</u>
Longitude <u>119°26'04.42501"W</u>	Easting <u>8474008.46</u>
NAD 83(1991)	Ortho Height <u>585.93</u>
	Ellipsoidal Height <u>516.02</u>

Location and Comments      Compass Declination      Surveyors Seal

From the junction of Westland Road and I84, go south on Col. Jordan Road 1.0 mile, then continue on Col. Jordan Road southeast 3.1 miles to County Line Road. Then go south on County Line Road 0.5 mile to the corner.

REGISTERED  
 PROFESSIONAL  
 LAND SURVEYOR

RECEIVED BY:

Date: 7-02  
 Rec'd By: DK  
 No. 02-186-g

Firm / Agency

Haddock Surveying  
 P. O. Box 1574  
 Pendleton, OR 97801  
 (541) 276-2174

*David L. Haddock*

OREGON  
 JULY 12, 1968  
 DAVID L. HADDOCK  
 852