


OREGON CORNER RESTORATION FORM

Section 15 Township 3N Range 27E
 County Umatilla Base 06-30-02

Corner Designation: 3N27N13
 Condition Report Only
 Not Found
 Remonumented
 Unrecorded
 Surveyed In
 Referenced Out

Previous Renewals / Surveys, etc.
 Corner set by GLO in 1920.
 Survey 99-49-B reports finding this monument.

Monument and Accessories Found: (condition and source)
 Found the record monument in good condition stamped as shown in the diagram below.

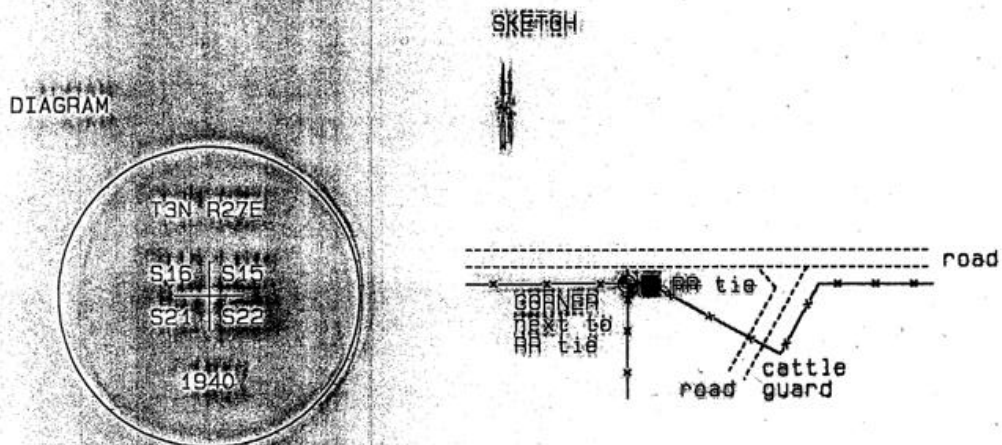

MONUMENT (S) AND ACCESSORIES SET (Procedures and Description)

None.

REFERENCES SET:

None.

Made GPS tie to TBM Station Stanfield East Base
 Latitude 45 24 04 697551N
 Longitude 119 26 04 406091W
 NAD 83 (1991)

Oregon State Plane Coord. - North Zone
 Northing 755424.18
 Easting 8474148.64
 Ortho Height 920.38
 Ellipsoidal Height 850.60

Location and Comments: Compass Direction 20°E
 From the junction of 164 and Westland Road, follow Jordan Road south 1.4 mile. Enter the posted Madison Farm Road and continue south 0.7 mile. Then follow a circle road south westerly 2.6 miles to a pumping station easily visible on the hill. Then go south 0.1 mile and south westerly 1 mile to the corner.

Surveyors Seal

REGISTERED
 PROFESSIONAL
 LAND SURVEYOR

David L. Haddock

OREGON
 JULY 12, 1968
 DAVID L. HADDOCK
 852

RENEWS 6-30-03

RECEIVED BY:

Date: 12-02
 Rec'd. By: AK
 No: 02-292-0

Firm / Agency

Haddock Surveying
 P.O. Box 1574
 Pendleton, OR 97801
 (541) 278-2174