

OREGON CORNER RESTORATION FORM

Section 6 Township 3N
County Umatilla Date: 09/15/09

Range 29E

Corner Designation: 3N29C1

1/4 corner common to sections 6, T3NR29E, 1,
T3NR28E.

_____	Condition Report Only
<u> X </u>	Not Found
_____	Remonumented
_____	Unrecorded
<u> X </u>	Surveyed In
<u> X </u>	Referenced Out


Previous Renewals / Surveys, etc.

Originally Surveyed by Gates in 1859. He set a post in a mound of earth.


Monuments and Accessories Found: (Condition and Source)

None.

Diagram

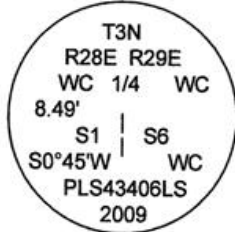

Sketch

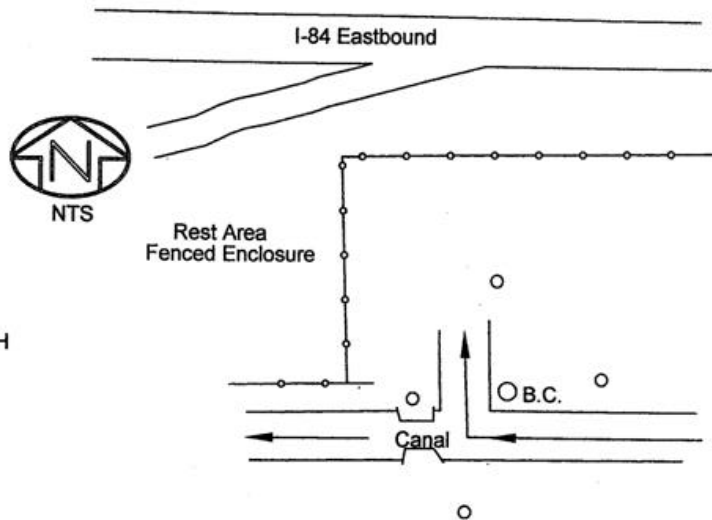

NAD 83/91
OREGON STATE PLANE NORTH
INTERNATIONAL FEET

N769153.25
E8521442.27

LAT - 45° 46' 10.469836" N
LON - 119° 14' 54.71104" W

Monument (s) Set (Procedures and Description)

Set a 2 1/2" Brass cap on a 1 1/8" x 30" galvanized iron pipe 4 inches above the surface using the West line of the township and best evidence of East-West fencelines as well as the canal.

References Set:

- A 5/8" Iron rebar w/rpc #43406 lies N 5°15' W, 23.16'.
- A 5/8" Iron rebar w/rpc #43406 lies N 85°45' E, 16.57'.
- A 5/8" Iron rebar w/rpc #43406 lies S 11° W, 23.65'.
- A 5/8" Iron rebar w/rpc #43406 lies S 80°45' W, 16.19'.

Location and Comments

From the East fenceline at the East Bound Rest Area on I-84 (West of the Echo-Stanfield exit), go to the Southeast corner of the fenced area. The monument is approximately 40' East across the canal, where it T's.

Compass Declination

17° E

Surveyors Seal

REGISTERED
PROFESSIONAL
LAND SURVEYOR

Robert D. English
OREGON
JANUARY 11, 2005
ROBERT DOUGLAS ENGLISH
43406LS

RECEIVED BY:

Date: 10-09
Rec'd By: KK
No. 09-146-R

Firm / Agency

Survey One, LLC.
P.O. Box 382
Pendleton, OR 97801
(541) 276-2055

RENEWAL DATE: 12/31/09