

OREGON CORNER RESTORATION FORM

Section 18
County Umatilla

Township 3N
Date: 09/15/09

Range 29E

Corner Designation: 3N29L1

1/4 corner common to sections 18, T3NR29E, 13, T3NR28E.

- _____ Condition Report Only
- _____ X _____ Not Found
- _____ Remonumented
- _____ Unrecorded
- _____ X _____ Surveyed In
- _____ X _____ Referenced Out


Previous Renewals / Surveys, etc.

Originally Surveyed by Gates in 1859. He set a post in a mound of earth.


Monuments and Accessories Found: (Condition and Source)

None.

Diagram

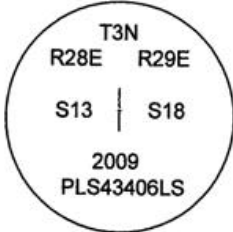

Sketch

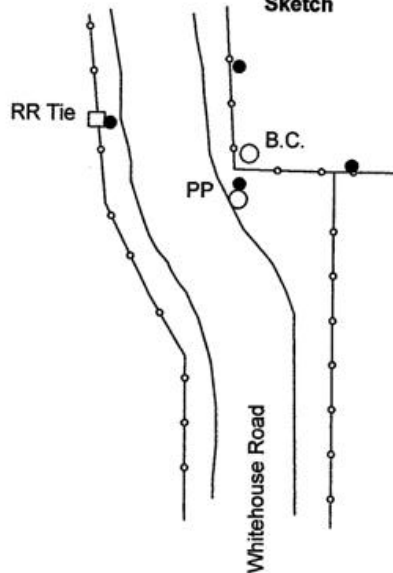

NAD 83/91
OREGON STATE PLANE NORTH
INTERNATIONAL FEET

N758499.05
E8521609.88

LAT - 45° 44' 25.56897" N
LON - 119° 14' 54.67499" W

Monument (s) Set (Procedures and Description)

Set a 2 1/2" Brass cap by single proportion between 2 found monuments on the West line of T3N29E. (N1 & R1) Proportioned distance fits the existing fence intersection well.

References Set:

- A 5/8" Iron rebar w/rpc #43406 under the fence lies N 2°15' W, 41.17'.
- A 5/8" Iron rebar w/rpc #43406 under the fence lies S 82°45' E, 38.92'.
- A pk nail w/ brass washer #43406 on a power pole lies S 22°30' W, 17.31'.
- A pk nail w/brass washer #43406 on a RR Tie fence post lies N 76° W, 50.21'.

Location and Comments

From the intersection of Hwy. 320 and Whitehouse Road, go 1.00 mile North on Whitehouse road.

Compass Declination

17° E

Surveyors Seal

REGISTERED
PROFESSIONAL
LAND SURVEYOR

Robert D. English
 OREGON
 JANUARY 11, 2005
 ROBERT DOUGLAS ENGLISH
 43406LS

RECEIVED BY:

Firm / Agency

Survey One, LLC.
P.O. Box 382
Pendleton, OR 97801
(541) 276-2055

Date: 10-09
 Rec'd By: KE
 No. 09-146-R

RENEWAL DATE: 12/31/09