

# CORNER RESTORATION FORM

Township 3N Range 28E Section 18 County UMATILLA

State OREGON Date 12/21/12 Number N1

Corner Designation : SOUTHWEST CORNER

- Condition Report Only
- Not Found
- Renewed
- Surveyed In
- Referenced


Previous Renewals \_\_\_\_\_

Monument (s) Found: (Condition and Source)

FOUND 2 1/2 INCH BRASS CAP ON BADLY BENT  
2 INCH O.D. PIPE. THE PIPE WAS STRAIGHTENED  
AND RESET AT FOUND POSITION. MONUMENT IS IN  
RECORD OF SURVEY FILED AS 00-33-B UMATILLA  
COUNTY SURVEY RECORDS.

MONUMENT DETAIL

Found  Set

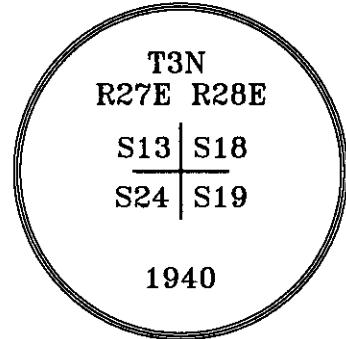

Accessories Found:


NONE

Monument & Accessories Set (Procedure and Description)

A STEEL FENCE POST WAS SET WEST AND ALONGSIDE

Sketch of Monument, Accessories and General Area

SEARCH AREA IS S.W OF 3-WAY  
INTERSECTION OF ROADS AROUND  
CENTER PIVOT FIELDS

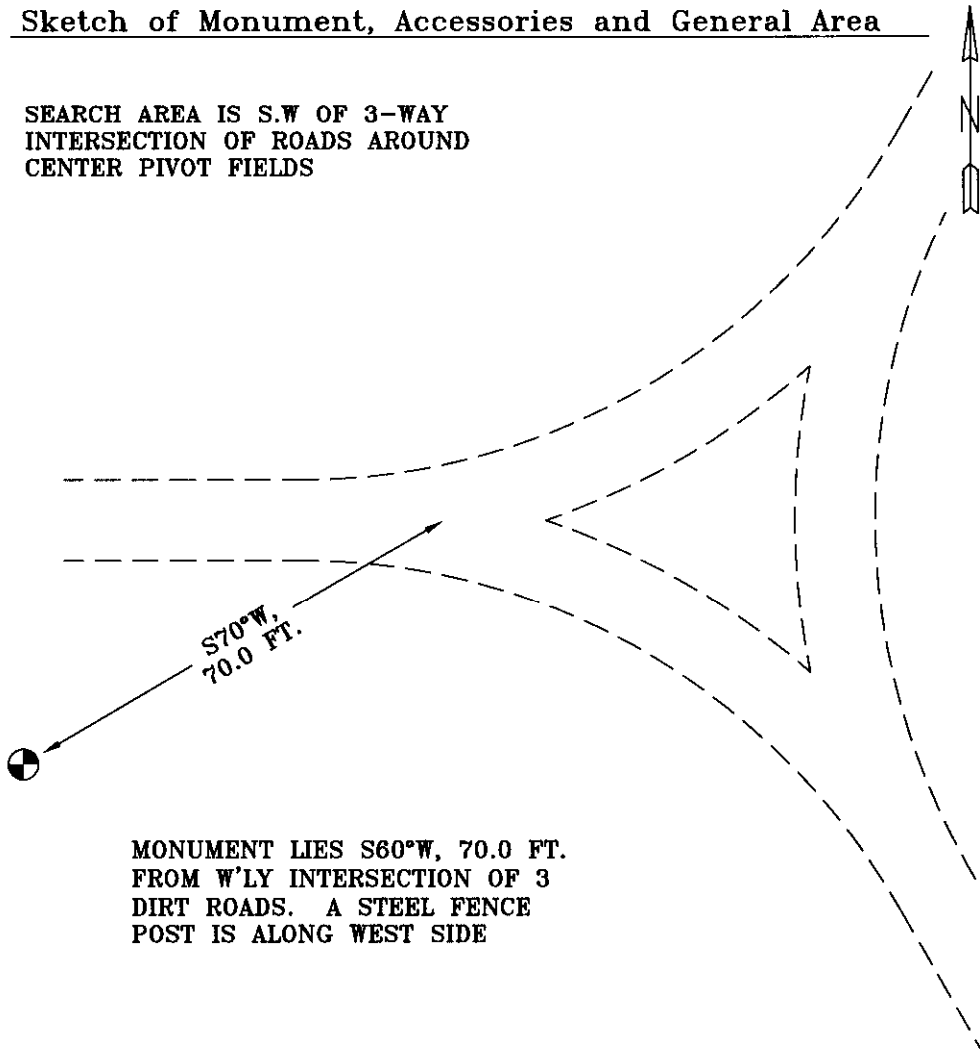

**REGISTERED  
PROFESSIONAL  
LAND SURVEYOR**

*Danny K. Cummings*

OREGON  
JAN. 21, 1988  
**DANNY K. CUMMINGS**  
2316

RENEWAL DATE : 12-31-13

Agency CK3, LLC.  
945 S.W. ORCHARD AVE., HERMISTON OR

Party Chief Rod Lewis  
Notekeeper Rod Lewis  
Witness(s) \_\_\_\_\_  
Field Book 0-287  
Client Cascade Natural Gas  
Job # VO-12051

**COUNTY SURVEYOR  
RECORDING INFO**

Received 2/1/2013  
Filed S. Rex  
Survey No. 13-015-C  
Drawing No. \_\_\_\_\_  
Index No. N-1