

# OREGON CORNER RESTORATION FORM

Section 20 Township 3N Range 28E  
 County Umatilla Date: 07-06-02

Corner Designation: 3N28R9

Condition Report Only  
 Not Found  
 Remonumented  
 Unrecorded  
 Surveyed In  
 Referenced Out

Previous Renewals / Surveys, etc.



Survey S-119-B records setting a brass capped monument here.  
 Survey 00-33-B records finding that monument.

Monument and Accessories Found: ( condition and source )

Found the brass capped monument in good condition as shown below.

SKETCH

DIAGRAM

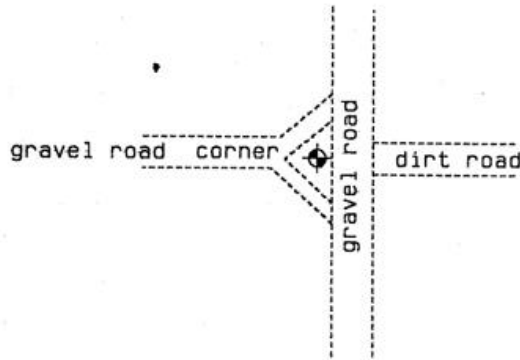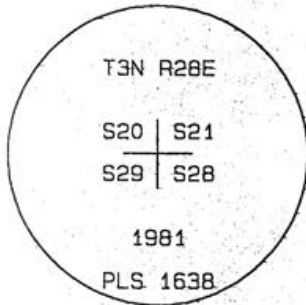

MONUMENT (S) AND ACCESSORIES SET (Procedures and Description)

None.

REFERENCES SET:

None.

Made GPS tie to TRI Station	Oregon State Plane Coord. - North Zone
Stanfield East Base	Northing 750374.61
Latitude 45°43'08.18520" N	Easting 8500543.54
Longitude 119°19'53.3460" W	Ortho Height 701.68
NAD 83 (1991)	Ellipsoidal Height 632.07

Location and Comments

Compass Declination  
20°E

Surveyors Seal

From the junction of highways 207 and 320, go north 0.6 mile. Then go west on a farm road 1.1 miles. The corner is at a T junction in the road.

REGISTERED  
PROFESSIONAL  
LAND SURVEYOR

RECEIVED BY:

Firm / Agency

*David L. Haddock*

Date: 12-02  
 Rec'd By: KK  
 No. 02-283-a

Haddock Surveying  
 P. O. Box 1574  
 Pendleton, OR 97801  
 (541) 276-2174

OREGON  
 JULY 12, 1968  
 DAVID L. HADDOCK  
 852

RENEWS 6-30-03