

**OREGON CORNER RESTORATION FORM**

Section 3 Township 3N Range 29E  
 County Umatilla Date: April 4, 1998

Corner Designation: **3N29E17**

Condition Report Only  
 Not found


Section corner common to sections 2, 3, 10, and 11,  
 T3N, R29E, W.M.

Remonumented  
 Unrecorded  
 Surveyed in  
 Referenced out

Previous Renewals / Surveys, etc.

Corner originally established by Gates in 1859 under contract No. 84 was a post and a mound of earth with charcoal.

Monument and Accessories found: ( condition and source )  
 None.

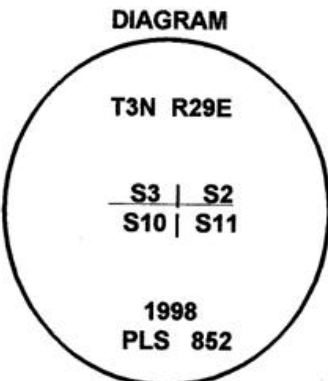

**MONUMENT (S) AND ACCESSORIES SET (Procedures and Description)**  
 At the intersection of a fence with fences running East, West, and South we set a 2 1/4 inch brass cap on a 1 1/8" x 24" galvanized iron pipe flush with the surface of the ground.

- REFERENCES SET:**
- A 5/8" x 24" rebar with a 1 1/8" red plastic cap stamped ORLS 852 and WALS 13922 bears S00°21'29"W, 19.72 feet under the fence.
  - A 5/8" x 24" rebar with a 1 1/8" red plastic cap stamped ORLS 852 and WALS 13922 bears S00°07'52"W, 79.67 feet under the fence.
  - A 5/8" x 24" rebar with a 1 1/8" red plastic cap stamped ORLS 852 and WALS 13922 bears N88°24'21"E, 54.09 feet under the fence.
  - A 5/8" x 24" rebar with a 1 1/8" red plastic cap stamped ORLS 852 and WALS 13922 bears N86°57'19"W, 18.81 feet at the foot of a power pole.

Location and comments

Compass Declination

Surveyors Seal

RECEIVED BY:  
Umatilla County Surveyor  
 Date: 8-98  
 Rec'd By: AK  
 No. 98-155-C

Firm / Agency  
 Haddock Surveying  
 Address  
 P.O. Box 1574  
 Pendleton, Or. 97801  
 Party Chief  
 Stephen K, Haddock

REGISTERED  
 PROFESSIONAL  
 LAND SURVEYOR

*David L. Haddock*

OREGON  
 JULY 12, 1908  
 DAVID L. HADDOCK  
 852

RECEIVED BY  
 Umatilla County Surveyor  
 Date: \_\_\_\_\_  
 Rec'd By: \_\_\_\_\_  
 No. \_\_\_\_\_