

**OREGON CORNER RESTORATION FORM**

Section 9,16  
County Umatilla

Township 3N  
Date: 08/18/09

Range 29E

Corner Designation: 3N29J11

1/4 Corner common to sections 9 and 16, T3NR29E.

- Condition Report Only
- Not Found
- Remonumented
- Unrecorded
- Surveyed In
- Referenced Out


**Previous Renewals / Surveys, etc.**

Originally Surveyed by N.H. Gates in 1859. He set a post in a mound of earth.  
A 1916 Railroad map call the corner a "rock".  
PLS 933 set a Brass Cap at the position of a found wagon axle in Survey S-158-C.  
PLS 852 set a 2 1/4" Brass Cap at the position of a found stone, coal, and broken pottery. May, 2008.


**Monuments and Accessories Found: (Condition and Source)**

A 2.5" B.C.  
A 5/8" Iron rebar w/rpc #852 @ Power Pole lies N 4° 00' W, 26.38'.  
A 3/4" Iron rebar lies S 89°00' E, 16.65'.

Diagram

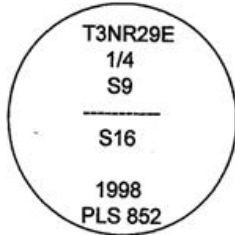

Sketch

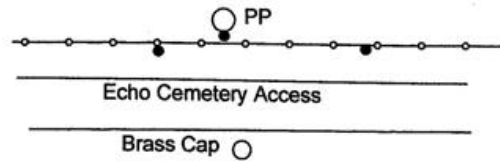

NAD 83/91  
OREGON STATE PLANE NORTH  
INTERNATIONAL FEET

N76500.63  
E8535424.17

LAT - 45° 44' 52.75835" N  
LON - 119° 11' 38.99875" W

**Monument (s) Set (Procedures and Description)**

None.

**References Set:**

A 5/8" x 30" Iron rebar w/ypc #43406 @ fence post lies N 33°45' E, 25.87'.  
A 5/8" x 30" Iron rebar w/ypc #43406 @ fence post lies N 48°00' W, 32.56'.

**Location and Comments**

The corner is located approx. 300 feet inside the entrance to the Echo Cemetery, and on the South edge of the road.

**Compass Declination**

17° E

**Surveyors Seal**

REGISTERED  
PROFESSIONAL  
LAND SURVEYOR

*Robert Douglas English*

OREGON  
JANUARY 11, 2005  
ROBERT DOUGLAS ENGLISH  
43406LS

**RECEIVED BY:**

Date: 10-09  
Rec'd By: KK  
No. 09-146-R

**Firm / Agency**

Survey One, LLC.  
P.O. Box 382  
Pendleton, OR 97801  
(541) 276-2055

RENEWAL DATE: 12/31/09