

**OREGON CORNER RESTORATION FORM**

Section 19  
County Umatilla

Township 3N  
Date: 09/21/09

Range 29E

**Corner Designation:** 3N29P1

1/4 Corner common to sections 19, T3NR29E, and 24, T3NR28E.

- Condition Report Only
- Not Found
- Remonumented
- Unrecorded
- Surveyed In
- Referenced Out

**Previous Renewals / Surveys, etc.**

Originally Surveyed by N.H. Gates in 1859. He set a post in a mound of earth.


**Monuments and Accessories Found: (Condition and Source)**

None.

**Diagram**



**Sketch**

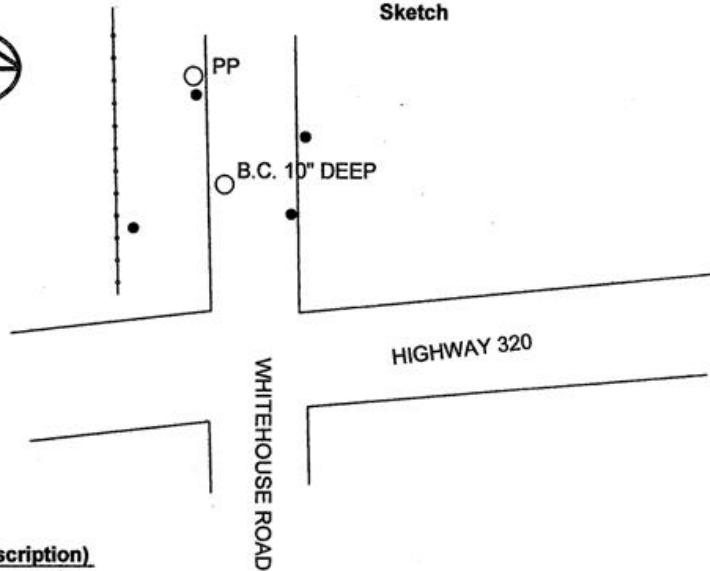

NAD 83/91  
OREGON STATE PLANE NORTH  
INTERNATIONAL FEET

N753167.20  
E8521708.30

LAT - 45° 43' 32.62379" N  
LON - 119° 14' 54.45888" W

**Monument (s) Set (Procedures and Description)**

Set a 1 1/4" x 30" galvanized iron pipe with a 2 1/2" brass cap, 10" below surface, stamped as shown above. Set by single proportionate measure.

**References Set:**

- A 3/8" x 30" Iron rebar w/rpc #43406 lies S 70°00' E, 18.77'.
- A 3/8" x 30" Iron rebar w/rpc #43406 lies S 66°00' W, 47.90'.
- A 3/8" x 30" Iron rebar w/rpc #43406 lies N 45°45' E, 29.98'.
- A 3/8" x 30" Iron rebar w/rpc #43406 lies N 9°30' W, 71.73'.

**Location and Comments**

The corner is North of the intersection of Hwy. 320 and Whitehouse Road.

**Compass Declination**

17° E

**Surveyors Seal**

REGISTERED  
PROFESSIONAL  
LAND SURVEYOR

*Robert D. English*  
OREGON  
JANUARY 11, 2005  
ROBERT DOUGLAS ENGLISH  
43406LS

**RECEIVED BY:**

Date: 1-11  
Rec'd By: KE  
No. 11-16-P

**Firm / Agency**

Survey One, LLC.  
P.O. Box 382  
Pendleton, OR 97801  
(541) 276-2055

RENEWAL DATE: 12/31/09