

OREGON CORNER RESTORATION FORM

Section 24,25 Township 3N
County Umatilla Date: 04/27/10

Range 29E

Corner Designation: 3N29R23

Corner common to sections 24,25 T3NR29E.

- Condition Report Only
- Not Found
- Remonumented
- Unrecorded
- Surveyed In
- Referenced Out


Previous Renewals / Surveys, etc.

Originally Surveyed by Gates in 1859. He set a post in a mound of earth.


Monuments and Accessories Found: (Condition and Source)

None.

Diagram

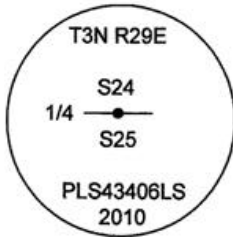

Sketch

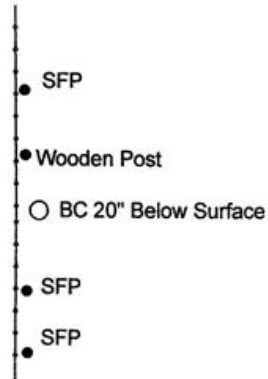

NAD 83/91
OREGON STATE PLANE NORTH
INTERNATIONAL FEET

N751226.63
E8551458.82
LAT - 45° 43' 08.70559" N
LON - 119° 07' 55.60382" W

Monument (s) Set (Procedures and Description)

A 1 1/2" x 30" galvanized iron pipe with a 2 1/2" brass cap, stamped as shown above. This corner was reset by single proportionate methods, which fit an existing ancient North-South fence very well, and apparent lines of occupation.

References Set:

- A 5/8" x 30" Iron rebar w/rpc #43406 lies N 11°20' E, 11.15'
- A 5/8" x 30" Iron rebar w/rpc #43406 lies S 4°30' W, 34.37'
- A 5/8" x 30" Iron rebar w/rpc #43406 lies S 11° W, 12.90'
- A 5/8" x 30" Iron rebar w/rpc #43406 lies N 2° W, 54.61'

Location and Comments

The corner is 2.0 miles south of the intersection of Coppinger Lane and Highway 320, and 0.5 miles West.

Compass Declination

17° E

Surveyors Seal

REGISTERED
PROFESSIONAL
LAND SURVEYOR

Robert D. English

OREGON
JANUARY 11, 2005
ROBERT DOUGLAS ENGLISH
43406LS

RECEIVED BY:

Date: 1-11
Rec'd By: KE
No. 11-17-R

Firm / Agency

Survey One, LLC.
P.O. Box 382
Pendleton, OR 97801
(541) 276-2055

RENEWAL DATE: 12/31/11