

**OREGON CORNER RESTORATION FORM**

Section 24  
County Umatilla

Township 3N  
Date: 04/27/10

Range 29E

Corner Designation: 3N29R25

Corner common to sections 24,25 T3NR29E, and sections 19,30, T3NR30E.  Condition Report Only

- Not Found
- Remonumented
- Unrecorded
- Surveyed In
- Referenced Out


**Previous Renewals / Surveys, etc.**

Originally Surveyed by David P. Thompson in 1859. He set a post in a mound of earth. Stratton set a 2 1/2" Brass cap at a hub that was surveyed in according to the land owners. D.Haddock found a 2 1/2" Brass cap.


**Monuments and Accessories Found: (Condition and Source)**

Found a 2 1/2" Brass cap.  
Found a 5/8" Iron rebar that lies N 89°00' E, 43.33'.  
Found a 5/8" Iron rebar that lies S 0°15' E, 39.50'.

**Diagram**

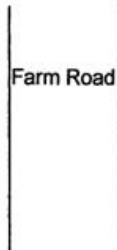

**Sketch**

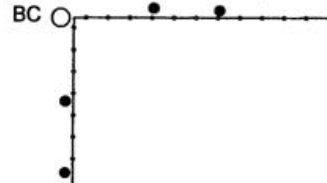

NAD 83/91  
OREGON STATE PLANE NORTH  
INTERNATIONAL FEET

N751290.50  
E8554057.56  
LAT - 45° 43' 08.912146" N  
LON - 119° 07' 18.7234" W

**Monument (s) Set (Procedures and Description)**

None.

**References Set:**

A 5/8" x 30" Iron rebar w/rpc #43406 lies N 89°30' E, 62.58' at base of steel fence post.  
A 5/8" x 30" Iron rebar w/rpc #43406 lies S 0° E, 53.32 at base of steel fence post.

**Location and Comments**

The corner is 2.0 miles south of the intersection of Coppinger Lane and Highway 320.

**Compass Declination**

17° E

**Surveyors Seal**

REGISTERED  
PROFESSIONAL  
LAND SURVEYOR

*Robert D. English*  
OREGON  
JANUARY II, 2005  
ROBERT DOUGLAS ENGLISH  
43406LS

RENEWAL DATE: 12/31/11

**RECEIVED BY:**

Date: 5-10  
Rec'd By: KR  
No. 10-85-R

**Firm / Agency**

Survey One, LLC.  
P.O. Box 382  
Pendleton, OR 97801  
(541) 276-2055