

OREGON CORNER RESTORATION FORM

Section 24
County Umatilla

Township 3N
Date: 04/27/10

Range 29E

Corner Designation: 3N29R25

Corner common to sections 24,25 T3NR29E, and sections 19,30, T3NR30E. Condition Report Only
 Not Found
 Remonumented
 Unrecorded
 Surveyed In
 Referenced Out


Previous Renewals / Surveys, etc.

Originally Surveyed by David P. Thompson in 1859. He set a post in a mound of earth.
Stratton set a 2 1/2" Brass cap at a hub that was surveyed in according to the land owners.
D.Haddock found a 2 1/2" Brass cap.


Monuments and Accessories Found: (Condition and Source)

Found a 2 1/2" Brass cap.
Found a 5/8" Iron rebar that lies N 89°00' E, 43.33'.
Found a 5/8" Iron rebar that lies S 0°15' E, 39.50'.

Diagram

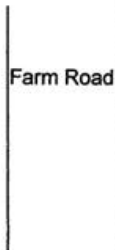

Sketch

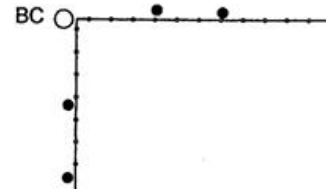

NAD 83/91
OREGON STATE PLANE NORTH
INTERNATIONAL FEET

N751287.22
E8554080.01
LAT - 45° 43' 08.86391" N
LON - 119° 07' 18.64940" W

Monument (s) Set (Procedures and Description)

None.

References Set:

A 5/8" x 30" Iron rebar w/rpc #43406 lies N 89°30' E, 62.58' at base of steel fence post.
A 5/8" x 30" Iron rebar w/rpc #43406 lies S 0° E, 53.32 at base of steel fence post.

Location and Comments

The corner is 2.0 miles south of the intersection of Coppinger Lane and Highway 320.

Compass Declination
17° E

Surveyors Seal

REGISTERED
PROFESSIONAL
LAND SURVEYOR

Robert D. English
OREGON
JANUARY 11, 2005
ROBERT DOUGLAS ENGLISH
43406LS

RECEIVED BY:

Date: 1-11
Rec'd By: KE
No. 11-17-R

Firm / Agency

Survey One, LLC.
P.O. Box 382
Pendleton, OR 97801
(541) 276-2055

RENEWAL DATE: 12/31/11